


WELL PLUGGING RECORD

Give All Information Completely  
Make Required Affidavit  
Mail or Deliver Report to:  
Conservation Division  
State Corporation Commission  
211 No. Broadway  
Wichita, Kansas

NORTH

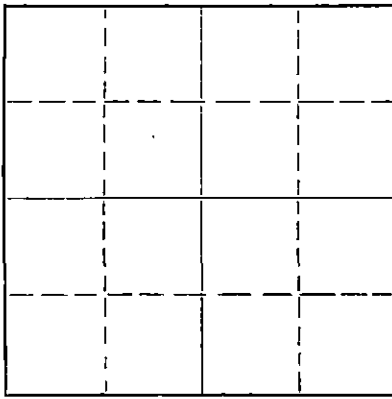

Locate well correctly on above  
Section Plat

Barton County. Sec. 33 Twp. 16 Rge. 12 (X) (W)  
Location as "NE/CNW/SW" or footage from lines SW NW SE  
Lease Owner Rio Hondo Oil & Developemnt Corporation  
Lease Name Prosser Well No. 2  
Office Address Box 45 Ellinwood, Kansas  
Character of Well (completed as Oil, Gas or Dry Hole) Dry Hole  
Date well completed October 9 1957  
Application for plugging filed October 9 1957  
Application for plugging approved October 9 1957  
Plugging commenced October 9 1957  
Plugging completed October 9 1957  
Reason for abandonment of well or producing formation Dry Hole

If a producing well is abandoned, date of last production \_\_\_\_\_ 19\_\_\_\_  
Was permission obtained from the Conservation Division or its agents before plugging was commenced? Yes

Name of Conservation Agent who supervised plugging of this well Harold Hollis  
Producing formation \_\_\_\_\_ Depth to top \_\_\_\_\_ Bottom \_\_\_\_\_ Total Depth of Well 3357 Feet  
Show depth and thickness of all water, oil and gas formations.


OIL, GAS OR WATER RECORDS

CASING RECORD

FORMATION	CONTENT	FROM	TO	SIZE	PUT IN	PULLED OUT
		0	317'	8 5/8	317'	None

Describe in detail the manner in which the well was plugged, indicating where the mud fluid was placed and the method or methods used in introducing it into the hole. If cement or other plugs were used, state the character of same and depth placed, from \_\_\_\_\_ feet to \_\_\_\_\_ feet for each plug set.

Filled hole with heavy mud to 300' Bridged hole at 300.  
Ran 20 sacks ash grove cement 300'-up. Heavy mud to 40'  
Ran 10 sacks to 40' to base of cellar.

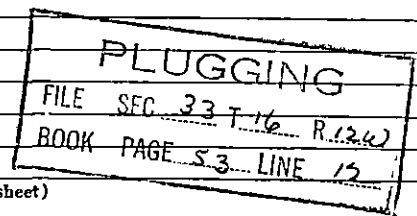

(If additional description is necessary, use BACK of this sheet)  
Name of Plugging Contractor Isern Drilling Company  
Address Box 45 Ellinwood, Kansas

STATE OF Barton COUNTY OF Kansas, ss.  
I, M. M. Shropshire (employee of owner) or (owner or operator) of the above-described well, being first duly sworn on oath, says: That I have knowledge of the facts, statements, and matters herein contained and the log of the above-described well as filed and that the same are true and correct. So help me God.

(Signature) M. M. Shropshire  
Lyons, Kansas (Address)

SUBSCRIBED AND SWORN TO before me this 10 day of October, 1957

My commission expires Feb 10, 1959

George Meyer  
Notary Public.

RECEIVED  
STATE CORPORATION COMMISSION  
10-12-1957  
OCT 12 1957

CONSERVATION DIVISION  
Wichita, Kansas

WELL LOG

RIO HONDO OIL & DEVELOPMENT CORP., Owner - PROSSER #2  
 SW/4 NW/4 SE/4 Section 33, Township 16S, Range 12W,  
 Barton County, Kansas

ELEVATION	1867 KB	Figures indicate bottom of formation	
		0 to	50 clay
			165 shale
			200 sand
PIPE RECORD:			335 shale & shells
			392 sand & pyrite
8-5/8" set at 317 feet			460 shale
Cemented with 175 sacks cement			754 Red rock
September 30, 1957			780 Anhydrite
			1200 shale & shells
			1450 salt
			1665 shale & shells
			2140 lime & shale
			2650 shale & shells
Rotary Commenced 9-30-57			3357 lime & shale
Completed 10-9-57			3357 Rotary Total
			Depth D&A

STATE OF KANSAS }  
 COUNTY OF BARTON } SS

I, M. M. Shropshire, Drilling Superintendent of the above-described well, being first duly sworn on oath, declare: That I have knowledge of the facts, statements and matters herein contained pertaining to the log of the above-described well, as filed, and that the same are true and correct.

M. M. Shropshire

Subscribed and Sworn to before me this 10th day of October, 1957.

George A. Mayer  
 Notary Public

My commission expires Feb. 10, 1959.

RECEIVED  
 STATE CORPORATION COMMISSION

PLUGGING  
 FILE SEC 33 T. 16 R. 12 W  
 BOOK PAGE 53 LI 12

OCT 12 1957  
 CONSERVATION DIVISION  
 Wichita, Kansas