


WELL PLUGGING RECORD

Give All Information Completely
Make Required Affidavit
Mail or Deliver Report to:
Conservation Division
State Corporation Commission
211 No. Broadway
Wichita, Kansas

NORTH

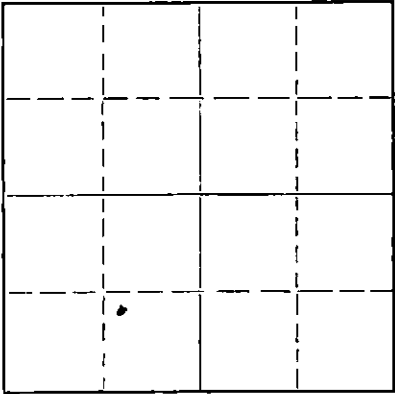

Locate well correctly on above Section Plat

Barton County. Sec. 33 Twp. 16 Rge. 12 (X) (W)
Location as "NE/CNW/SW" or footage from lines NW SE SW
Lease Owner Rio Hondo Oil & Development Corporation
Lease Name Schneweis Well No. 2
Office Address Box 45 Ellinwood, Kansas
Character of Well (completed as Oil, Gas or Dry Hole) Dry Hole
Date well completed September 28 1957
Application for plugging filed September 28 1957
Application for plugging approved September 28 1957
Plugging commenced September 28 1957
Plugging completed September 28 1957
Reason for abandonment of well or producing formation Dry Hole

If a producing well is abandoned, date of last production _____ 19____
Was permission obtained from the Conservation Division or its agents before plugging was commenced? Yes

Name of Conservation Agent who supervised plugging of this well Eldon Petty
Producing formation _____ Depth to top _____ Bottom _____ Total Depth of Well 3379 Feet
Show depth and thickness of all water, oil and gas formations.

OIL, GAS OR WATER RECORDS

CASING RECORD

FORMATION	CONTENT	FROM	TO	SIZE	PUT IN	PULLED OUT
<u>Surface</u>	<u>Pipe</u>	<u>0</u>	<u>330'</u>	<u>8 5/8"</u>	<u>330'</u>	<u>None</u>

Describe in detail the manner in which the well was plugged, indicating where the mud fluid was placed and the method or methods used in introducing it into the hole. If cement or other plugs were used, state the character of same and depth placed, from _____ feet to _____ feet for each plug set.

Filled hole with heavy mud to 320' Bridged hole at 320'. ran 20 sacks of cement 320'-up. Heavy mud up to 40' Bridged hole at 40' Ran 10 sacks 40' to base of cellar.

(If additional description is necessary, use BACK of this sheet)

Name of Plugging Contractor Isern Drilling Company
Address Box 45, Ellinwood, Kansas

STATE OF KANSAS, COUNTY OF BARTON, ss.
I, M. M. Shropshire (employee of owner) or (owner or operator) of the above-described well, being first duly sworn on oath, says: That I have knowledge of the facts, statements, and matters herein contained and the log of the above-described well as filed and that the same are true and correct. So help me God.

(Signature) M. M. Shropshire
Lyons, Kansas (Address)

SUBSCRIBED AND SWORN TO before me this 28th day of September, 1957

George Meyer Notary Public.

My commission expires Feb. 10, 1959

PLUGGING
FILE SEC. 33 T. 16 R. 12 W
BOOK PAGE 49 LINE 43

OCT 2 1957
STATE CORPORATION COMMISSION
WATER DIVISION
10-2-1957

WELL LOG

Rio Hondo Oil & Development Corporation, Owner Schneeweis #2
 NW SE SW Section 33, Township 18, Range 12
 Barton County, Kansas

ELEVATION: 1892 KB

Figures indicate bottom of formation
 0 to 60 clay
 175 shale
 215 sand
 375 shale & sand
 435 sand
 510 shale & shells
 782 Red rock
 810 Anhydrite
 1215 shale & shells
 1455 salt
 1620 shale & shells
 2150 lime & shale
 2650 shale & shells
 3090 lime & shale
 3345 lime & shale
 3370 lime, shale & chert
 3379 Arbuckle
 3379 Rotary TD

PIPE RECORD:

8-5/8" set at 330'
 Cemented with 175 sacks
 September 18, 1957

Rotary Commenced 9-18-57
 Completed 9-28-57

STATE OF KANSAS)
 COUNTY OF BARTON) SS

I, M. M. Shropshire, Drilling Superintendent of the above-described well, being first duly sworn on oath, declare: That I have knowledge of the facts, statements and matters herein contained pertaining to the log of the above-described well, as filed, and that the same are true and correct.

M. M. Shropshire

Subscribed and sworn to before me this 28th day of September, 1957

George H. Meyer
 Notary Public

My commission expires Feb. 10, 1959

RECEIVED
 STATE CORPORATION COMMISSION

FEB 7 1958

STATE CORPORATION DIVISION

PLUGGING
 FILE SEC 33 T 16 R 124
 BOOK PAGE 49 LINE 43