


WELL PLUGGING RECORD

Give All Information Completely
Make Required Affidavit
Mail or Deliver Report to:
Conservation Division
State Corporation Commission
800 Biting Building
Wichita, Kansas

NORTH

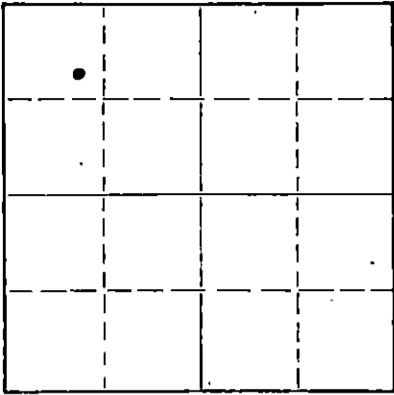

Locate well correctly on above Section Plat

Barton County. Sec. 33 Twp. 16 Rge. 12 (X) (W)
Location as "NE/CNW/SW" or footage from lines SE/4 NW/4 NW/4
Lease Owner Derby Drilling Company
Lease Name Schneweis Well No. 3
Office Address 352 North Broadway, Wichita, Kansas
Character of Well (completed as Oil, Gas or Dry Hole) oil well
Date well completed January 13 19 50
Application for plugging filed January 16, 1956 19 56
Application for plugging approved " 19 56
Plugging commenced January 17 19 56
Plugging completed " 19 56
Reason for abandonment of well or producing formation: well no longer commercially productive
If a producing well is abandoned, date of last production June 19 55
Was permission obtained from the Conservation Division or its agents before plugging was commenced? Yes

Name of Conservation Agent who supervised plugging of this well Mr. Brundege
Producing formation Arbuckle Depth to top _____ Bottom _____ Total Depth of Well 3347 Feet
Show depth and thickness of all water, oil and gas formations.

OIL, GAS OR WATER RECORDS

CASING RECORD

FORMATION	CONTENT	FROM	TO	SIZE	PUT IN	PULLED OUT
				8-5/8	180'	0'
				5-1/2	3347'	0'

Describe in detail the manner in which the well was plugged, indicating where the mud fluid was placed and the method or methods used in introducing it into the hole. If cement or other plugs were used, state the character of same and depth placed, from _____ feet to _____ feet for each plug set.

Ran bailer 17 times, and put in 180' of sand on top of plug at 326 1/4' - plug back to 308 1/4' - dumped 5 sacks of cement - plugged back to 30 1/4' - dumped rock bridge on top of cement - run bailer, checked fluid at 2100' - top of plug at 30 1/4' - filled hole with mud to 175' of top - bridge with rock - dumped 10 sacks cement - dumped rock bridge, put in 40' of mud and dumped 5 sacks of cement - top of cement 6' from top of ground - (as per state orders by Mr. Brundege).

RECEIVED
STATE CORPORATION COMMISSION
FEB 24 1956
CONSERVATION DIVISION
Wichita, Kansas
2-24-1956

(If additional description is necessary, use BACK of this sheet)
Name of Plugging Contractor Rocket Drilling Company, Inc.
Address 352 North Broadway, Wichita, Kansas

STATE OF KANSAS, COUNTY OF SEDGWICK, ss.
L. H. Myrick (employee of owner) or (owner) of the above-described well, being first duly sworn on oath, says: That I have knowledge of the facts, statements, and matters herein contained and the log of the above-described well as filed and that the same are true and correct. So help me God.

(Signature) L. H. Myrick
352 North Broadway, Wichita, Kansas
(Address)

SUBSCRIBED AND SWORN to before me this 23 day of February, 19 56

My commission expires 10/28/1959

Joanne Helmer Jones
Notary Public.

PLUGGING
SEC 33 T 16 R 12W
BOOK PAGE 31 LINE 41

15-009-07159-00-00

Derby Drilling Company, et al
Production Department
Wichita, Kansas

Schneweis #3
SE NW NW, 33-16S-12W
Barton County, Kansas

Elevation: 1884 D.F.
Spudded: December 28, 1949
Rotary Completed: January 8, 1950
Cable Tools Completed:
Acid Treatment:
Initial Production:
Contractor: Derby Drilling Company

CASING RECORD

180' 8-5/8" O.D. 24# Casing cemented with 125 sacks cement
3344' 5-1/2" O.D. 14# Seamless cemented with 125 sacks cement

DRILLERS LOG

Shale & shells 0 to 180
Shale, sand & iron 650
Shale 773
Anhydrite 798
Shale & shells 1150
Shale & lime 1635
Lime & shale 1775
Lime broken 1925
Lime 2030
Lime & shale 2175
Lime broken 2285

Lime & shale 2285 to 2615
Lime 2995
Shale 3069
Lime 3347 T.D.

3347 T.D. = 3345 D.F.

STATE OF KANSAS)
) ss.
COUNTY OF SEDGWICK)

I hereby certify that to the best of my knowledge and belief, the foregoing log is true and correct.

DERBY DRILLING COMPANY

By M. S. Davis

Subscribed and sworn to before me, a Notary Public, in and for the State and County aforesaid this 17 day of January, 1950

My Commission Expires Sept 16 1952

RECEIVED
STATE CORPORATION COMMISSION
FEB 24 1956
CONSERVATION DIVISION
Wichita, Kansas

PLUGGING
FILE SEC 33 T16 R12W
DGS MAG 31 LINE 41