


WELL PLUGGING RECORD

Give All Information Completely
Make Required Affidavit
Mail or Deliver Report to:
Conservation Division
State Corporation Commission
800 Bittling Building
Wichita, Kansas

NORTH

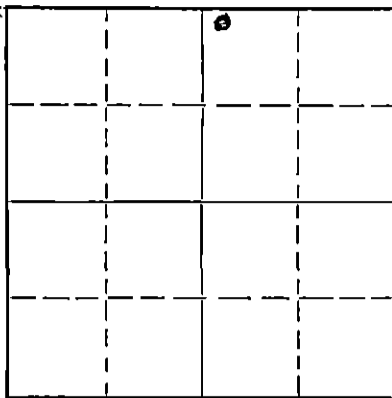

Locate well correctly on above
Section Plat

Barton County. Sec. 33 Twp. 16 Rge. (E) 12 (W)
Location as "NE/CNW $\frac{1}{4}$ SW $\frac{1}{4}$ " or footage from lines NW NW NE
Lease Owner Keyes Drilling Company
Lease Name Scheweis Well No. 1
Office Address Ellinwood, Kansas
Character of Well (completed as Oil, Gas or Dry Hole) _____
Date well completed August 6, 1949 19____
Application for plugging filed January 25, 1950 19____
Application for plugging approved January 28, 1950 19____
Plugging commenced Feb 2, 1950 19____
Plugging completed Feb 8, 1950 19____
Reason for abandonment of well or producing formation well went to water
If a producing well is abandoned, date of last production November 8, 1949 19____
Was permission obtained from the Conservation Division or its agents before plugging was commenced? Yes

Name of Conservation Agent who supervised plugging of this well C. Stough
Producing formation Arbuckle Depth to top 3349 Bottom _____ Total Depth of Well 3358 Feet
Show depth and thickness of all water, oil and gas formations.

OIL, GAS OR WATER RECORDS

CASING RECORD

Formation	Content	From	To	Size	Put In	Pulled Out
				8 5/8	178	none
				5 1/2	3350	2198'

Describe in detail the manner in which the well was plugged, indicating where the mud fluid was placed and the method or methods used in introducing it into the hole. If cement or other plugs were used, state the character of same and depth placed, from _____ feet to _____ feet for each plug set.

Rocked hole to 3345'. Run 5 sacks of cement.
Mudded hole to 176'. Set rock bridge and run 15 sacks of cement.
Mudded hole to 35'. Run 10 sacks of cement.
Well Completed.

FEB 28 1950
2-23-1950
STAMP


(If additional description is necessary, use BACK of this sheet)
Correspondence regarding this well should be addressed to Keyes Drilling Company
Address Ellinwood, Kansas

STATE OF KANSAS, COUNTY OF BARTON, SS.
J. G. W. Keyes, Part Owner (employed by/owner) of the above-described well,
being first duly sworn on oath, says: That I have knowledge of the facts, statements, and matters herein contained and the log of the above-described well as filed and that the same are true and correct. So help me God.

(Signature) J. G. W. Keyes
Ellinwood, Kansas
(Address)

SUBSCRIBED AND SWORN to before me this 21st day of February, 1950
George A. Meyer
Notary Public.

My commission expires February 10, 1951

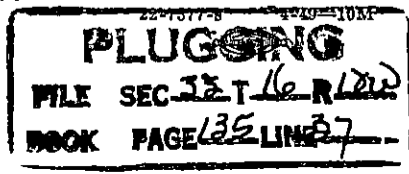

15-009-07160-00-00
WELL LOG

G. B. Koyes, et al, Owners - Schmevels No. 1
NW 1/4 NW 1/4 Section 33, Township 16S, Range 12 W,
Barton County, Kansas

Figures indicate bottom of formation
to 0

55 shale and post rock
285 shale and shells
310 shale and sand
460 sand and pyrite
490 shale and sand
600 red bed and shale
810 sandstone
1215 shale and shells
1340 salt and shells
1465 shale and shells
1610 shale and sandy lime

1585 sand and shale
2055 lime and shale
2075 lime
2105 shale and lime
2175 shale and shells
2555 shale and lime
2660 shale and shells
2855 lime and shale
2975 lime
3070 shale and lime
3135 lime
3210 lime and shale
3334 lime
3341 shale
3373 lime
3373 equals 3353 corrected meas.

Casing record:
8 5/8" set at 175' H.M.
5 1/2" set at 335 1/2' H.M.

Tape corrected to derrick floor

Topoka 2882
Hobbs 2988
Doss Creek 3016
Dross Lime 3074
Lansing 3096
Arbuckle 3349

Rotary commenced 7-10-49 completed
Cable tools commenced 7-29-49 completed
8-6-49

CABLE TOOL WORK
Ran in cable tools, washed hole, drilled cement and
cleaned hole out to bottom. Drilled deeper.
3353
3359 Total Depth of

State of Kansas
County of Barton) SS

I, G. B. Koyes, Part Owner of the above-described well, being first duly sworn on oath,
deposes that I have knowledge of the facts, statements, and matters herein contained
pertaining to the log of the above-described well, as filed, and that the same are true
and correct.

Subscribed and sworn to before me this 23rd day of August, 1949.

PLUGGING
FILE SEC 33 16 R 12
BOOK PAGE 35 LINE 37

Notary Public

[Signature]
JAN 2 1950

[Signature]

By commission expires Feb. 10, 1950