


WELL PLUGGING RECORD

Give All Information Completely
Make Required Affidavit
Mail or Deliver Report to:
Conservation Division
State Corporation Commission
211 No. Broadway
Wichita, Kansas

Barton County. Sec. 33 Twp. 16 Rge. 12W (E) (W)
Location as "NE/CNW/SW" or footage from lines SE SE SE
Lease Owner T. L. Nutt
Lease Name Prosser Well No. 1
Office Address Box 407, Ellinwood, Kansas
Character of Well (completed as Oil, Gas or Dry Hole) Oil
Date well completed September 7 19 54
Application for plugging filed May 5 19 58
Application for plugging approved May 6 19 58
Plugging commenced May 8 19 58
Plugging completed May 10 19 58
Reason for abandonment of well or producing formation Not Commercial
If a producing well is abandoned, date of last production February 19 58
Was permission obtained from the Conservation Division or its agents before plugging was commenced? Yes

NORTH

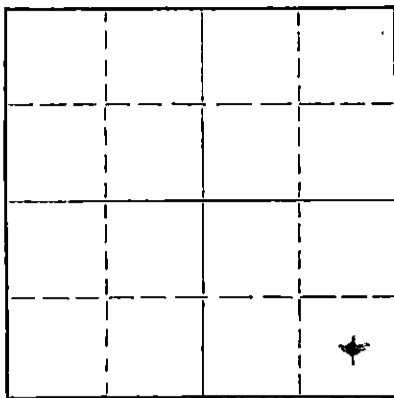

Locate well correctly on above Section Plat

Name of Conservation Agent who supervised plugging of this well Donald Truen
Producing formation Arbuckle Depth to top _____ Bottom _____ Total Depth of Well 3336 Feet
Show depth and thickness of all water, oil and gas formations.

OIL, GAS OR WATER RECORDS				CASING RECORD		
FORMATION	CONTENT	FROM	TO	SIZE	PUT IN	PULLED OUT
				8 5/8"	205'	None
				5 1/2"	3336'	2810'

Describe in detail the manner in which the well was plugged, indicating where the mud fluid was placed and the method or methods used in introducing it into the hole. If cement or other plugs were used, state the character of same and depth placed, from _____ feet to _____ feet for each plug set.

3336' - 3300' - Sand
3300' - 3275' - Cement
3275' - 215' - Mud
215' - 200' - Rock
200' - 125' - cement
125' - 40' - mud
40' - 30' - rock
30' - 0 - cement

JUN 13 1958
6-13-1958
CONSERVATION DIVISION
Wichita, Kansas

(If additional description is necessary, use BACK of this sheet)
Name of Plugging Contractor Glenn & Smith Pipe Pulling Co
Address Ellinwood, Kansas

STATE OF Kansas, COUNTY OF (Barton), ss.
T. L. Nutt (employee of owner) or (owner or operator) of the above-described well, being first duly sworn on oath, says: That I have knowledge of the facts, statements, and matters herein contained and the log of the above-described well as filed and that the same are true and correct. So help me God.

(Signature) T. L. Nutt
Box 407 Ellinwood, Kansas
(Address)

SUBSCRIBED AND SWORN to before me this 11th day of June, 19 58
Ullanda Nichols
Notary Public.

My commission expires April 1, 1959

PLUGGING
FILE SEC. 33 T. 16 R. 12W
BOOK PAGE 98 LINE 26

WELL LOG BUREAU—KANSAS GEOLOGICAL SOCIETY
508 East Murdock, Wichita, Kansas

COPY


Company- ICER ADDIS
Farm- Prosser

No. 1

SEC. 33 T. 16 R. 12W
SE SE SE

Total Depth. 3336
Comm. 8-26-54 Comp. 9-7-54
Shot or Treated.
Contractor, Mast Drilling, Inc.
Issued. 11-13-54

County Barton
KANSAS

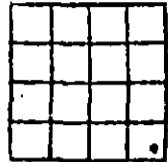

Elevation. 1854

Production. Pump 46 bbls., 50%
water

CASING:

5" 3336

Figures indicate Bottom of Formations.

clay & loam	16
sand	26
shale & lime shells	176
sand	184
shale & shells	350
pyrite	375
red bed	555
shale & chalk	731
anhydrite	764
shale & lime shells	1219
salt	1370
lime	2125
lime & shale	2555
lime	2665
shale & lime	2775
lime	3314
sand	3316
lime	3336
Total Depth	

SCOUT TOPS:

Lansing	3056
Arbuckle	3316

RECORDED
INDEXED
JUN 13 1954
KANSAS GEOLOGICAL SOCIETY

PLUGGING
FILE SEC. 33 T. 16 R. 12W
BOOK PAGE 99 LINE 24