


Give All Information Completely  
Make Required Affidavit  
Mail or Deliver Report to:  
Conservation Division  
State Corporation Commission  
212 North Market, Insurance Bldg.  
Wichita, Kansas

WELL PLUGGING RECORD

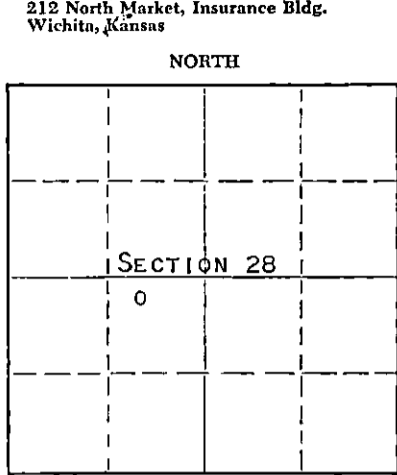

Locate well correctly on above Section Plat

STAFFORD County. Sec. 28 Twp. 21 Rge. 12 (W)  
Location as "NE/CNW&SW" or footage from lines NW NE SW  
Lease Owner PETROLEUM, INC.  
Lease Name SITTNER "D" Well No. 1  
Office Address ROUTE 2, GREAT BEND, KANSAS  
Character of Well (completed as Oil, Gas or Dry Hole) OIL  
Date well completed 7/17 19.53  
Application for plugging filed 4/18 19.61  
Application for plugging approved 4/20 19.61  
Plugging commenced 4/24 19.61  
Plugging completed 4/28 19.61  
Reason for abandonment of well or producing formation DEPLETION OF ALL PRODUCTIVE FORMATIONS  
If a producing well is abandoned, date of last production AUGUST 1 19.58  
Was permission obtained from the Conservation Division or its agents before plugging was commenced? YES

Name of Conservation Agent who supervised plugging of this well FRANK BROADFOOT, ST. JOHN, KANSAS  
Producing formation ARBUCKLE Depth to top 3587' Bottom --- Total Depth of Well 3637' Feet  
Show depth and thickness of all water, oil and gas formations.

OIL, GAS OR WATER RECORDS

CASING RECORD

FORMATION	CONTENT	FROM	TO	SIZE	PUT IN	PULLED OUT
ARBUCKLE	WATER & LITTLE OIL	3594'	3602'	8-5/8" 5-1/2"	227' 3635'	NONE 3000'

Describe in detail the manner in which the well was plugged, indicating where the mud fluid was placed and the method or methods used in introducing it into the hole. If cement or other plugs were used, state the character of same and depth placed, from \_\_\_ feet to \_\_\_ feet for each plug set.

PLUGGED BACK T.D. 3607'

FILLED HOLE WITH CRUSHED ROCK TO 3580'. PLACED 5 SACKS CEMENT ON TO CRUSHED ROCK. MUDDED UP WITH HEAVY MUD TO 200' AND BUILT SOLID ROCK BRIDGE, PLACED 20 SACKS CEMENT ON TOP OF ROCK BRIDGE. MUDDED UP WITH HEAVY MUD TO 40' AND BUILT SOLID ROCK BRIDGE. PLACED 10 SACKS CEMENT ON TO ROCK BRIDGE TO BASE OF WELL CELLAR.

**RECEIVED**  
 STATE CORPORATION COMMISSION  
 MAY 5 1961  
 CONSERVATION DIVISION  
 Wichita, Kansas

(If additional description is necessary, use BACK of this sheet)

Name of Plugging Contractor MORGAN WELL PLUGGING SERVICE  
Address 102 WEST 18TH STREET, HUTCHINSON, KANSAS

STATE OF KANSAS, COUNTY OF BARTON, ss.  
DON SEARLE (employee of owner) or (owner) of the above-described well, being first duly sworn on oath, says: That I have knowledge of the facts, statements, and matters herein contained and the log of the above-described well as filed and that the same are true and correct. So help me God.

(Signature) Don Searle

ROUTE 2, GREAT BEND, KANSAS  
(Address)

SUBSCRIBED AND SWORN TO before me this 2ND day of MAY, 19 61

My commission expires APRIL 14, 1963

Arthur J. Miles  
Notary Public.



DRILLER'S LOG SITTNER 'D' #1

Petroleum, Inc., Operator

Section 28, Twp. 21S, Rge. 12W

Garvey Drilling Company, Contractor

Location: NW NE SW

Drilling Commenced: June 23, 1953

County: Stafford County, Kansas

Drilling Completed: July 4, 1953

R.T.D: 3637'

Casing Record: 8 5/8" @ 227' w/220 sax  
5 1/2" @ 3635' w/75 sax

Production: Arbuckle

Figures below indicate bottom of formation:

65	Sand
217	Sand & Shale
646	Shale & Red Bed
672	Anhydrite
1400	Shale & Shells
3005	Shale & Lime
3178	Lime
3243	Shale
3506	Lime
3532	Chert
3534	Shale
3588	Shale & Sand
3637	Lime

Tops:

Heebner:	3122 (-1264)
Brown Lime:	3255 (-1397)
Lansing :	3269 (-1411)
Arbuckle:	3587 (-1729)

DST, 3590-97, open 1 hr., rec. 120' heavily  
oil cut mud, 1825' oil, 1070# BHP.  
DST, 3600-08, open 1 hr., rec. 2760' oil,  
BHP 1085#.

3637' R.T.D.

I hereby certify that this is a true and correct log of the above mentioned well.

PETROLEUM, INC.

**RECEIVED**  
STATE CORPORATION COMMISSION

MAY 5 1961

By W. W. T. H.

STATE OF KANSAS )  
                          )  
COUNTY OF SEDGWICK )

CONSERVATION DIVISION  
Wichita, Kansas

SS: \_\_\_\_\_

Subscribed to and sworn to before me, a Notary Public, in said County and State, this 6th day of July, 1953.

Charlotte Heidman  
Notary Public

My commission expires: October 13, 1954.