


STATE OF KANSAS
STATE CORPORATION COMMISSION

Form CP-4

WELL PLUGGING RECORD

Give All Information Completely
Make Required Affidavit
Mail or Deliver Report to:
Conservation Division
State Corporation Commission
P. O. Box 17027

Wichita, Kansas 67217
NORTH

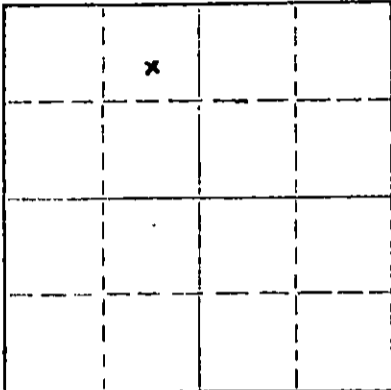

Locate well correctly on above
Section Plat

Stafford County, Sec. 32 Twp. 21S Rge. 12W (E) (W)
Location as "NE/CN/WSW" or footage from lines S/2 NE/4 NW/4
Lease Owner Clinton Oil Company
Lease Name Mueller #1 Well No.
Office Address Great Bend, Kansas 67530
Character of Well (completed as Oil, Gas or Dry Hole) Oil
Date well completed 8-12 1944
Application for plugging filed 12-15 1971
Application for plugging approved 12-16 1971
Plugging commenced 1/25/72 19
Plugging completed 1/31/72 19
Reason for abandonment of well or producing formation depleted.
If a producing well is abandoned, date of last production 12/ 19 69
Was permission obtained from the Conservation Division or its agents before plugging was commenced? yes

Name of Conservation Agent who supervised plugging of this well Biberstein
Producing formation Arbuckle Depth to top 3618 Bottom 3623 Total Depth of Well 3662 Feet
Show depth and thickness of all water, oil and gas formations.

OIL, GAS OR WATER RECORDS

CASING RECORD

FORMATION	CONTENT	FROM	TO	SIZE	PUT IN	PULLED OUT
				8-5/8	227	none
				5 1/2"	3602'	none

Describe in detail the manner in which the well was plugged, indicating where the mud fluid was placed and the method or methods used in introducing it into the hole. If cement or other plugs were used, state the character of same and depth placed, from _____ feet to _____ feet for each plug set.

Checked hole to 3602', ran sand to 3600' and 5 sacks of cement.
Bailed hole to 400', set 10' rock bridge and ran 4 yards concrete.

PLUGGING COMPLETE.

RECEIVED
STATE CORPORATION COMMISSION
FEB 15 1972
CONSERVATION DIVISION
Wichita, Kansas

(If additional description is necessary, use BACK of this sheet)
Name of Plugging Contractor KNIGHT CASING PULLING CO., INC.
Address CHASE, KANSAS

STATE OF KANSAS COUNTY OF RICE, ss.
NOEL J. KNIGHT (employee of owner) or (owner or operator) of the above-described well, being first duly sworn on oath, says: That I have knowledge of the facts, statements, and matters herein contained and the log of the above-described well as filed and that the same are true and correct. So help me God.

(Signature) Noel Knight
CHASE, KANSAS
(Address)

Sworn to before me this 31st day of January, 1972
MARGARET MELCHER
NOTARY PUBLIC
Rice County, Kansas
My Commission Expires Feb. 15, 1975

Margaret Melcher
Notary Public.

3603
1571/3