


STATE OF KANSAS  
STATE CORPORATION COMMISSION

Give All Information Completely  
Make Required Affidavit  
Mail or Deliver Report to:  
Conservation Division  
State Corporation Commission  
211 No. Broadway  
Wichita, Kansas

WELL PLUGGING RECORD

Stafford County. Sec. 32 Twp. 21 Rge. (E) 12 (W)  
Location as "NE/CNWxSWx" or footage from lines C. NL NW NE  
Lease Owner Isern-Wells  
Lease Name Umstead Well No. 1  
Office Address Box 486, Ellinwood, Kansas  
Character of Well (completed as Oil, Gas or Dry Hole) oil  
Date well completed April 1 1964  
Application for plugging filed June 5 1964  
Application for plugging approved \_\_\_\_\_ 19\_\_\_\_  
Plugging commenced June 10 1964  
Plugging completed June 12 1964  
Reason for abandonment of well or producing formation depleted

NORTH

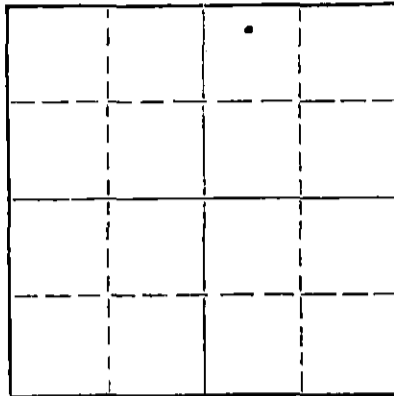

Locate well correctly on above  
Section Plat

If a producing well is abandoned, date of last production April 1964  
Was permission obtained from the Conservation Division or its agents before plugging was commenced? yes

Name of Conservation Agent who supervised plugging of this well Archie V. Elving  
Producing formation \_\_\_\_\_ Depth to top \_\_\_\_\_ Bottom \_\_\_\_\_ Total Depth of Well 3599 Feet  
Show depth and thickness of all water, oil and gas formations.

OIL, GAS OR WATER RECORDS

CASING RECORD

FORMATION	CONTENT	FROM	TO	SIZE	PUT IN	PULLED OUT
		0	282'	8 5/8"	282	none
		0	3589	5 1/2"	3589	1763.98

Describe in detail the manner in which the well was plugged, indicating where the mud fluid was placed and the method or methods used in introducing it into the hole. If cement or other plugs were used, state the character of same and depth placed, from \_\_\_\_\_ feet to \_\_\_\_\_ feet for each plug set.

Push plug to 3550', set 10' rock bridge and dump 5 sacks of cement.

Set bridge plug at 270', set 15' rock bridge and dump 4 sacks of

cement and 10 lbs. calcium chloride. Let set 3 hours. Bail hole

down to 230' and dump 21 sacks of cement. Fill hole with mud to

40', set 10' rock bridge and cap with 10 sacks of cement.

RECEIVED  
STATE CORPORATION COMMISSION

JUN 22 1964

CONSERVATION DIVISION  
Wichita, Kansas

Name of Plugging Contractor Pipe Pullers, Inc.  
Address Box 486, Ellinwood, Kansas

STATE OF Kansas, COUNTY OF Barton, ss.  
Dean Wells (employee of owner) or (owner or operator) of the above-described well, being first duly sworn on oath, says: That I have knowledge of the facts, statements, and matters herein contained and the log of the above-described well as filed and that the same are true and correct. So help me God.

(Signature) *Dean Wells*

Ellinwood, Kansas  
(Address)

SUBSCRIBED AND SWORN to before me this 19 day of June, 1964

My commission expires July 7, 1964

Notary Public.

Well: Unstead No. 1  
 Owner: G. W. Keyes Drilling Company  
 Commenced: 3-17-44  
 Completed: 4-15-44 Producer  
 Elevation: 1862

282' Surface Pipe cemented with 120 sacks, cement circulated  
 3598' of 5 $\frac{1}{2}$ " OD cemented with 125 sacks

225	Sand
260	Shale
282	Red Rock
600	Red bed and shale
650	Shale & shells
680	Anhydrite
985	Red BED and shale
1220	R R shale, salt
1390	Shale & shells
1470	Sandy lime
1495	Anhydrite
1705	Lime and shale
1825	Bro. lime
2050	Lime
2250	Bro. lime
2630	Shale & shells
2610	Shale
2656	Lime broken
2755	Shale & shells
2845	Shale & lime
3195	Lime
3276	Shale & lime
3393	Lime
3403	Soft lime
3450	Lime
3490	Shale & lime
3503	Lime
3505	Chert
3530	Chert & lime
3546	Chert & lime
3556	Shale
3585	Lime Simpson
3606	Lime Arbuckle
Total depth	3606

**RECEIVED**  
 STATE CORPORATION COMMISSION

JUN 8 1964

CONSERVATION DIVISION  
 Wichita, Kansas