

Give All Information Completely
Make Required Affidavit
Mail or Deliver Report to:
Conservation Division
State Corporation Commission
211 No. Broadway
Wichita, Kansas

WELL PLUGGING RECORD

Stafford County. Sec. 32 Twp. 21 Rge. (E) 12 (W)

Location as "NE/CNW&SW&" or footage from lines NW NE NE

Lease Owner Isern-Wells

Lease Name Umstead Well No. 2

Office Address Box 486, Ellinwood, Kansas

Character of Well (completed as Oil, Gas or Dry Hole) oil

Date well completed August 20 1964

Application for plugging filed June 5 1964

Application for plugging approved 19


Plugging commenced June 6 1964

Plugging completed June 9 1964

Reason for abandonment of well or producing formation depleted

If a producing well is abandoned, date of last production April 1964

Was permission obtained from the Conservation Division or its agents before plugging was commenced? yes

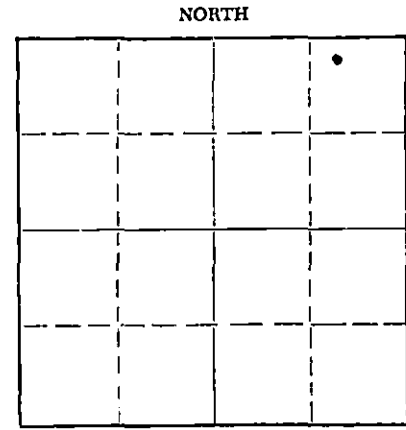

Locate well correctly on above Section Plat

Name of Conservation Agent who supervised plugging of this well Archie V. Elving

Producing formation _____ Depth to top _____ Bottom _____ Total Depth of Well 3611 Feet

Show depth and thickness of all water, oil and gas formations.

OIL, GAS OR WATER RECORDS

CASING RECORD

FORMATION	CONTENT	FROM	TO	SIZE	PUT IN	PULLED OUT
		0	275'	8 5/8"	275	none
		0	3610	5 1/2"	3610	898.62

Describe in detail the manner in which the well was plugged, indicating where the mud fluid was placed and the method or methods used in introducing it into the hole. If cement or other plugs were used, state the character of same and depth placed, from _____ feet to _____ feet for each plug set.

Push plug to 3550', set 10' rock bridge and dump 5 sacks of cement.

Set bridge plug at 260', set 15' rock bridge and dump 2 sacks of

cement and 10 lbs. calcium chloride. Bail hole down to 245' and

dump 23 sacks of cement. Fill hole with mud to 40', set 10' rock

bridge and cap with 10 sacks of cement.

RECEIVED
STATE CORPORATION COMMISSION

JUN 22 1964

CONSERVATION DIVISION
Wichita, Kansas

6-22-1964

(If additional description is necessary, use BACK of this sheet)

Name of Plugging Contractor Pipe Pullers, Inc.

Address Box 486, Ellinwood, Kansas

STATE OF Kansas COUNTY OF Barton, ss.
Dean Wells (employee of owner) or (owner or operator) of the above-described

well, being first duly sworn on oath, says: That I have knowledge of the facts, statements, and matters herein contained and the log of the above-described well as filed and that the same are true and correct. So help me God.

(Signature) *Dean Wells*

Ellinwood, Kansas
(Address)

SUBSCRIBED AND SWORN to before me this 19 day of June, 1964

My commission expires July 7, 1964

Notary Public.

WELL LOG

G. W. Keyes Drilling Company, Owner - Umstead #2

NW NE NE Section 32, Township 21 S, Range 12 W.
Stafford County, Kansas

Figures indicate bottom of formation

		0	to	235 Sand
				670 Red Bed
				700 Anhydrite
Elevation	1879			830 Shale and shells
				1060 Shale
Tops, Rotary Bushing Measurements				1245 Shale and salt
				1730 Shale and shells
Lansing	3275			1780 Sandy lime
Viola	3512			1900 Shale, shells and broken lime
Simpson	3547			2015 Shale and shells
Arbuckle	3607			2106 Lime shells
				2165 Lime
				2260 Broken lime
				2330 Lime
Pipe:				2400 Broken lime and shale
8 5/8" set at 275				2555 Shale and shells
5 1/2" set at 3611				2765 Shale
				2860 Shale and shells
				2935 Shale and lime
				2948 Shale
				3267 Lime
				3327 Shale
				3350 Lime
				3356 Broken lime
				3448 Lime
				3512 Lime and shale
				3547 Lime
				3566 Lime cherty
				3607 Shale
				3613 Shale and lime
				3613 Total Depth

Started August 6, 1945
Completed Rotary August 19, 1945.

State of Kansas }
County of Barton } ss

I, G. W. Keyes, Part Owner of the above-described well, being first duly sworn on oath, declare: That I have knowledge of the facts, statements and matters herein contained pertaining to the log of the above-described well as filed and that the same are true and correct.

Subscribed and Sworn to before me this 9th day of February, 1946.

My commission expires July 7, 1948.

RECEIVED
STATE CORPORATION COMMISSION

JUN 8 1964

CONSERVATION DIVISION
Wichita, Kansas

G. W. Keyes
J. J. Rader