

WELL PLUGGING RECORD

Give All Information Completely
Make Required Affidavit
Mail or Deliver Report to:
Conservation Division
State Corporation Commission
212 North Market, Insurance Bldg.
Wichita, Kansas

Stafford County, Sec. 32 Twp. 21 Rge. 12 (E) (W)

Location as "NE/CNW/SW" or footage from lines NE7SE7SE

Lease Owner Great Bend Pipe & Supply

Lease Name Walker "B" Well No. 1

Office Address Drawer "B", Great Bend, Kansas

Character of Well (completed as Oil, Gas or Dry Hole)

Date well completed 19

Application for plugging filed 19

Application for plugging approved 19


Plugging commenced 6-6 19 61

Plugging completed 6-16 19 61

Reason for abandonment of well or producing formation

If a producing well is abandoned, date of last production 19

Was permission obtained from the Conservation Division or its agents before plugging was commenced? Yes

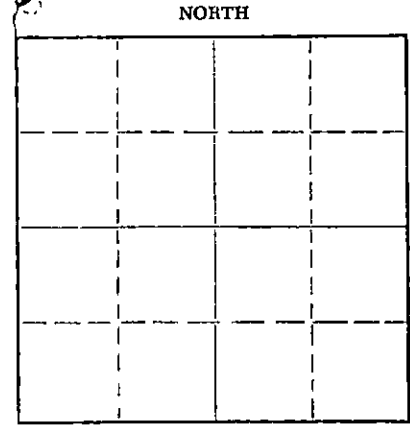

Locate well correctly on above Section Plat

Name of Conservation Agent who supervised plugging of this well Frank Broadfoot

Producing formation Depth to top Bottom Total Depth of Well 3672 Feet

Show depth and thickness of all water, oil and gas formations.

OIL, GAS OR WATER RECORDS

CASING RECORD

FORMATION	CONTENT	FROM	TO	SIZE	PUT IN	PULLED OUT
				8 5/8	270	None
				5 1/2	3668	2750

Describe in detail the manner in which the well was plugged, indicating where the mud fluid was placed and the method or methods used in introducing it into the hole. If cement or other plugs were used, state the character of same and depth placed, from feet to feet for each plug set.

Plug @ 3664
Top Perforation 3629

Sanded to 3600' - dumped 5 sks cement - pulled casing - mudded hole to 240' - set 10' rock bridge - dumped 20 sks cement - mudded to 40' - set 10' rock bridge - dumped 10 sks cement

RECEIVED
STATE CORPORATION COMMISSION

JUL 14 1961

CONSERVATION DIVISION
Wichita, Kansas

7-14-1961

(If additional description is necessary, use BACK of this sheet)

Name of Plugging Contractor R & D Casing Pulling Co License # 236
Address Box # 572, Hutchinson, Kansas

STATE OF Kansas COUNTY OF Bartow, ss.

Nathan Meltyer (employee of owner) or (owner or operator) of the above-described well, being first duly sworn on oath, says: That I have knowledge of the facts, statements, and matters herein contained and the log of the above-described well as filed and that the same are true and correct. So help me God.

(Signature) Nathan Meltyer

(Address)

SUBSCRIBED AND SWORN TO before me this 11th day of July, 1961

Richard P. Brack

Notary Public.

My commission expires July 27, 1963

INVOICED

DATE 7/18/61

INV. NO. 3384-W


WELL LOG BUREAU—KANSAS GEOLOGICAL SOCIETY
508 East Murdock, Wichita, Kansas

Company- IRON DRILLING CO.
Farm- Walker No. 2

SEC. 32 T. 21 R. 12W
NE SE SE

Total Depth. 3635'
Comm. 2-7-58 Comp. 2-18-58
Shot or Treated.
Contractor. Iron Drlg.
Issued. 4-26-58

County Stafford
KANSAS

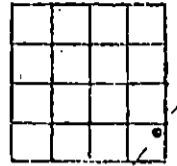

CASING:
8 5/8" 263' cem w/200 sx.

Elevation. 1867' RB

Production. Dry

Figures indicate Bottom of Formations.

sand & clay	50
shale	80
sand & gravel	200
red bed	263
red bed & sand	430
red bed	640
Anhydrite	665
shale	1440
lime shells	1500
lime	1805
shale & lime	1865
salt	1880
shale & lime	3039
lime	3155
lime & shale	3265
lime	3500
lime & chert	3559
cherty lime	3576
lime	3610
Conglomerate	3630
Arbuckle	3633
lime	3635
Total Depth	
TOPS: SCOUT	
Brown Lime	3270
Lansing	3286
Base Kansas City	3514
Conglomerate	3523
Arbuckle	3630