


WELL PLUGGING RECORD

Give All Information Completely
Make Required Affidavit
Mail or Deliver Report to:
Conservation Division
State Corporation Commission
211 No. Broadway
Wichita, Kansas

Stafford County, Sec. 32 Twp. 21S Rge. (E) 12 (W)
Location as "NE/CNW%SW%" or footage from lines NE SE SE
Lease Owner Iron Drilling Company
Lease Name Walker Well No. 2
Office Address 1206 Philtower Bldg., Tulsa 3, Oklahoma
Character of Well (completed as Oil, Gas or Dry Hole) Dry Hole
Date well completed 2-19-58 19
Application for plugging filed 2-19-58 19
Application for plugging approved 2-19-58 19
Plugging commenced 2-19-58 19
Plugging completed 2-19-58 19
Reason for abandonment of well or producing formation _____

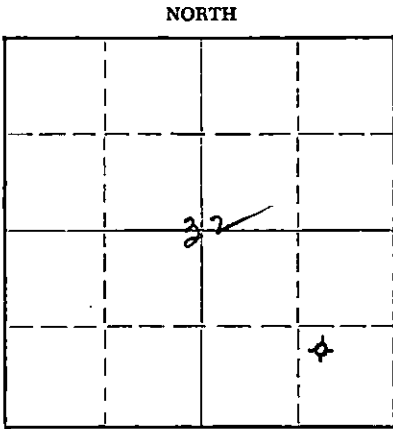

Locate well correctly on above Section Flat

If a producing well is abandoned, date of last production None 19
Was permission obtained from the Conservation Division or its agents before plugging was commenced? yes

Name of Conservation Agent who supervised plugging of this well W. L. Lac Kamp, Jr.
Producing formation _____ Depth to top _____ Bottom _____ Total Depth of Well 3635 Feet
Show depth and thickness of all water, oil and gas formations.

OIL, GAS OR WATER RECORDS

CASING RECORD

FORMATION	CONTENT	FROM	TO	SIZE	PUT IN	PULLED OUT
Heebner		3137		8-5/8	263	none
Toronto		3158				
Douglas		3170				
Brown Lime		3270				
Lansing		3286				
Arbuckle		3630				

Describe in detail the manner in which the well was plugged, indicating where the mud fluid was placed and the method or methods used in introducing it into the hole. If cement or other plugs were used, state the character of same and depth placed, from _____ feet to _____ feet for each plug set.

Hole filled with heavy mud to 245 feet. Set wood plug w/ 1/3 sack of hulls and 20 sacks of cement through drill pipe. Filled hole with mud to 35'. Set wood plug with 1/3 sack of hulls and 10 sacks of cement.

RECEIVED
MAY 7 1958
CONSERVATION DIVISION
Wichita, Kansas
3-9-1958

(If additional description is necessary, use BACK of this sheet)

Name of Plugging Contractor Iron Drilling Company
Address 1206 Philtower Building, Tulsa 3, Oklahoma

STATE OF Oklahoma, COUNTY OF Tulsa, ss.
J. L. Stackpole (employee of owner) or (owner or operator) of the above-described well, being first duly sworn on oath, says: That I have knowledge of the facts, statements, and matters herein contained and the log of the above-described well as filed and that the same are true and correct. So help me God.

(Signature) J. L. Stackpole
1206 Philtower Bldg., Tulsa, Oklahoma
(Address)

SUBSCRIBED AND SWORN TO before me this 5th day of March, 19 58

My commission expires February 28, 1960

B. Michal
Notary Public.

PLUGGING
FILE SEC 32 T 21 R 12W
BOOK PAGE 85 LINE 5

15-185-19510-0000

IRON DRILLING COMPANY

1206 PHILTOWER BUILDING

TULSA 3, OKLAHOMA

Well: Walker No. 2
NE SE SE 32-21S-12W
Stafford County, Kansas

263' - 8-5/8" Surface
Casing cemented
with 200 sacks.

Work Commenced: 2- 7-58
Drilling Commenced: 2- 7-58
Drilling Completed: 2-18-58
Work Completed: 2-20-58

WELL LOG

Sand & clay	0	to	50
Shale	50	to	80
Sand & gravel	80	to	200
Red bed	200	to	263
Red bed & sand	263	to	430
Red bed	430	to	640
Anhydrite	640	to	665
Shale	665	to	1440
Lime shells	1440	to	1500
Lime	1500	to	1805
Shale & lime	1805	to	1865
Salt	1865	to	1880
Shale & lime	1880	to	3039
Lime	3039	to	3155
Lime & shale	3155	to	3265
Lime	3265	to	3500
Lime & chert	3500	to	3559
Cherty lime	3559	to	3576
Lime	3576	to	3610
Conglomerate	3610	to	3630
Arbuckle	3630	to	3633
Lime	3633	to	3635 T.D.

RECEIVED
STATE CORPORATION COMMISSION

MAR 7 1958

CONSERVATION DIVISION
Wichita, Kansas

PLUGGING	
FILE	SEC 32 T 21 R 12 W
BOOK	PAGE 85 LINE 5