

WELL PLUGGING RECORD

STATE OF KANSAS
STATE CORPORATION COMMISSION

Give All Information Completely
Make Required Affidavit
Mail or Deliver Report to:
Conservation Division
State Corporation Commission
800 Bittling Building
Wichita, Kansas

OR


FORMATION PLUGGING RECORD

Strike out upper line
when reporting plugging
off formations.

Stafford County. Sec. 32 Twp. 21 Rge. (E) 12 (W)

Location as "NE 1/4 NW 1/4 SW 1/4" or footage from line Gen. S.L. NW NE
Lease Owner. G W Keyes Drlg. Co. et al
Lease Name. Umstead Well No. 3
Office Address. Ellinwood, Kansas
Character of Well (completed as Oil, Gas or Dry Hole) Dry Hole
Date well completed. 4-8-48 19
Application for plugging filed. 4-27-48 19
Application for plugging approved. 4-28-48 19
Plugging commenced. 4-28-48 19
Plugging completed. 5-5-48 19
Reason for abandonment of well or producing formation. Dry Hole

NORTH

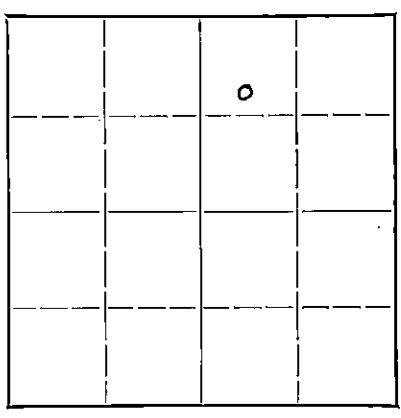

Locate well correctly on above
Section Plat

If a producing well is abandoned, date of last production. none 19
Was permission obtained from the Conservation Division or its agents before plugging was commenced? Yes

Name of Conservation Agent who supervised plugging of this well. C. D. Stough
Producing formation. none Depth to top. - - - Bottom. - - - Total Depth of Well. 3618 Feet

Show depth and thickness of all water, oil and gas formations.

OIL, GAS OR WATER RECORDS

CASING RECORD

Formation	Content	From	To	Size	Put In	Pulled Out
	Surface Pipe	0	280'	8 5/8"	280'	none
	Oil String	0	3613'	5 1/2"	3613'	2711'

Describe in detail the manner in which the well was plugged, indicating where the mud fluid was placed and the method or methods used in introducing it into the hold. If cement or other plugs were used, state the character of same and depth placed, from...feet to...feet for each plug set.

Ran 5 sacks of cement in bottom of hole. Filled with heavy mud to 278'. Set rock bridge and cemented with 15 sacks on top of bridge. Mudded back to 30', set rock bridge and cemented to top.

5-27-1948

MAY 27 1948

(If additional description is necessary, use BACK of this sheet)

Correspondence regarding this well should be addressed to G W Keyes Drilling Company
Address. Ellinwood, Kansas

STATE OF Kansas, COUNTY OF Barton, ss.
I, G. W. Keyes, Part Owner of the above-described well,


being first duly sworn on oath, says: That I have knowledge of the facts, statements, and matters herein contained and the log of the above-described well as filed and that the same are true and correct. So help me God.

(Signature) G W Keyes
Ellinwood, Kansas (Address)

SUBSCRIBED AND SWORN TO before me this 15th day of May, 1948.

George A. Meyer
Notary Public.

My commission expires Feb. 10, 1951.

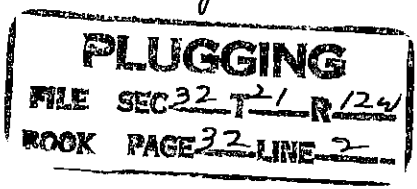

STATE OF KANSAS

15-185-11596-0000

INVOICE

May 27, 1948

To: G. W. Keyes Drilling Co.
Ellinwood, Kansas

STATE CORPORATION COMMISSION
CONSERVATION DIVISION

800 BITTING BUILDING
WICHITA, KANSAS

For: PLUGGING ASSESSMENT AS FOLLOWS:

Umstead Well No. 3
CSL NW NE Sec. 32-21-13W, Stafford County
File No. 32-2

\$ 25.00

NOTE: You neglected to include a copy of the drillers log with your application and plugging record form. Kindly send us a log in order that we may have a complete file for the above described well.

#2617
Paid
6-11-48
M C-57
H

TO INSURE CORRECT APPLICATION KINDLY
RETURN PINK COPY WITH REMITTANCE



15.185.11596.0000

G. W. KEYES DRILLING CO., et al, Owners - Umstead #3
Gen SL NW NE Section 32, Township 21, Range 12 West,
Stafford County, Kansas

Figures indicate bottom of formation

Elevation *1869 D3*

Casing Record

8 5/8" set at 280'
5 1/2" set at 3613'

Tops, corrected 3' to derrick floor

Heebner shale 3129
Base Oread 3161
Brown Lime 3261
Lansing 3284
Base K.C. 3496
Viola Chert 3518
Simpson shale 3553
Arbuckle Dolomite 3610

Rotary Commenced 2-15-48
Completed 2-26-48

Cable Tools Commenced 2-28-48
Completed 4- 8-48

0 to 220 sand
235 shale
600 red bed
658 shale and shells
693 anhydrite
1150 shale and shells
1350 salt and shale
1490 shale and shells
1640 shale and lime
1965 lime
2125 lime and shale
2820 shale and shells
2915 broken lime
3150 lime
3260 lime and shale
3442 lime
3535 lime and shale
3556 lime chert
3617 shale
3619 lime
3619 Total Rotary Depth

CABLE TOOL WORK

Moved in cable tools, bailed hole, drilled cement and cleaned out to total rotary depth. Drilled deeper acidized w/500 gal. Swabbed & tested. 3616 to 3618 Lime (DFM) 3618 T.D. D & A.

STATE OF KANSAS)
COUNTY OF BARTON) SS

MAY 29 1948

I, G. W. Keyes, Part Owner of the above-described well, being first duly sworn on oath, declare: That I have knowledge of the facts statements and matters herein contained pertaining to the log of the above-described well, as filed, and that the same are true and correct.

G. W. Keyes

Subscribed and Sworn to before me this 26th day of April 1948.

George A. Meyer
Notary Public

My Commission Expires Feb 10, 1951

FILE SEC 37 21 R 12 W
BOOK PAGE 32 LINE 2

This check is in payment of items as per statement following. Endorsement of payee will constitute a receipt in full when check is paid.
— Detach statement before depositing check —

DATE	INVOICE NO.	AMOUNT	DISCOUNT	NET AMOUNT
5-27	to G. W. Keyes Drilling Co.	25.00		
	Umstead 25.00 plugging assessment #3			

15.185.11596.0000

0000-121118121