


WELL PLUGGING RECORD

Give All Information Completely
Make Required Affidavit
Mail or Deliver Report to:
Conservation Division
State Corporation Commission
800 Bittling Building
Wichita, Kansas

NORTH

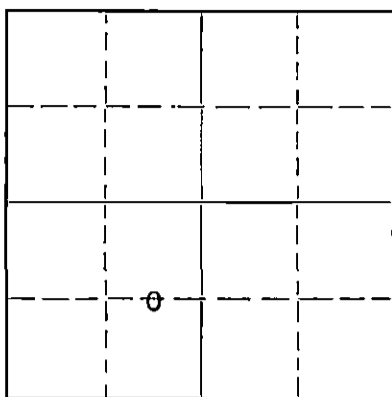

Locate well correctly on above
Section Plat

Stafford County. Sec. 32 Twp. 21S Rge. (E) 12 (W) 12
Location as "NE/CNW $\frac{1}{4}$ SW $\frac{1}{4}$ " or footage from lines 990' E. of W. line & 660' N. of S
Lease Owner Norbla Oil Co. & Burke-Greis Oil Corp. line
Lease Name Walker Well No. 1
Office Address 1207 Philtower Tulsa, Okla.
Character of Well (completed as Oil, Gas or Dry Hole) Dry hole
Date well completed 3-25-50 19
Application for plugging filed 3-25-50 19
Application for plugging approved 3-25-50 19
Plugging commenced 3-25-50 19
Plugging completed 3-25-50 19
Reason for abandonment of well or producing formation Dry
If a producing well is abandoned, date of last production none 3-25 19 50
Was permission obtained from the Conservation Division or its agents before plugging was commenced? Yes

Name of Conservation Agent who supervised plugging of this well G. D. Stough
Producing formation none Depth to top Bottom Total Depth of Well Feet
Show depth and thickness of all water, oil and gas formations.

OIL, GAS OR WATER RECORDS

CASING RECORD

Formation	Content	From	To	Size	Put In	Pulled Out
Lansing	Dry	3289'	3527'	8-5/8 OD	673'	0
Conglomerate	Dry	3527'	3573'			
Simpson	Dry	3573'	3631'			
Arbuckle Chert	Dry	3631'	3633'			
Arbuckle Dolomite	Dry	3633'	3636'	TD		

Describe in detail the manner in which the well was plugged, indicating where the mud fluid was placed and the method or methods used in introducing it into the hole. If cement or other plugs were used, state the character of same and depth placed, from 250' feet to 40' feet for each plug set.

Circulated 10.5# 48 vis mud until hole was full of heavy mud. Placed Halliburton plug at 250' and spotted 15 sx cement on top of plug. Placed Halliburton plug 40' and filled surface csg with cement to bottom of cellar.

4-8-50

RECORDED
APR 8 1950
STATE CORPORATION COMMISSION
KANSAS

(If additional description is necessary, use BACK of this sheet)
Correspondence regarding this well should be addressed to Norbla Oil Company
Address 1207 Philtower Tulsa, Oklahoma

STATE OF Oklahoma, COUNTY OF Tulsa, ss.
H. J. Stone (employee of owner) or (owner or operator) of the above-described well,
being first duly sworn on oath, says: That I have knowledge of the facts, statements, and matters herein contained and the log of the above-described well as filed and that the same are true and correct. So help me God.
(Signature) *H. J. Stone*
1207 Philtower Tulsa, Oklahoma
(Address)

SUBSCRIBED AND SWORN to before me this 6 day of April, 19 50

B. Michal
Notary Public.

My commission expires Feb 28, 1952

PLUGGING
FILE SEC 32 T 21 R 124
BOOK PAGE 144 LINE 45

Norbia Oil Company and Burke-Greis Oil Corporation
 Walker #1
 990' E of W line & 660' N of S line
 Section 32-21S-12W, Stafford County, Kansas
 Commenced 3-14-50 Completed 3-25-50
 Dry Elev. 1868'

From	To	Formation
0	505	Sand & Red Bed
505	666	Red Bed
666	1400	Anhydrite & Shale
1400	1613	Shale & Lime
1613	1730	Lime
1730	1865	Lime
1865	2007	Lime & Ft. Riley
2007	2135	Lime
2135	2250	Lime & shale
2250	2265	Lime
2265	2465	Shale
2465	2643	Shale
2643	2835	Shale
2835	2947	Shale
2947	3037	Shale & Lime
3037	3124	Lime & shale
3124	3240	Lime (Topeka)
3240	3289	Shale
3289	3527	K. C. Lansing Lime
3527	3573	Conglomerate
3573	3631	Simpson shale
3631	3633	Arbuckle chert
3633	3635	Arbuckle dolomite T.D.

1868
 666
 1400

PLUGGING
 FILE SEC 32-21S-12W
 PAGE LINE 45

1868 1868