


WELL PLUGGING RECORD

FORMATION PLUGGING RECORD

STATE OF KANSAS STATE CORPORATION COMMISSION Give All Information Completely Make Report to: Conservation Division State Corporation Commission 800 Bitting Building Wichita, Kansas

Strike out upper line when reporting plugging of formations.

Stafford County. Sec. 32 Twp. 21 Rge. (E) 12 (W) Location as "NE 1/4 NW 1/4 SW 1/4" or footage from lines SE SE SW Lease Owner Westgate-Greenland Oil Company Lease Name Walker Well No. 1 Office Address 1022 Union National Bank Building, Wichita 2, Kansas Character of Well (completed as Oil, Gas or Dry Hole) dry hole Date well completed April 7, 1949 Application for plugging filed April 25, 1949 Application for plugging approved April 25, 1949 Plugging commenced April 25, 1949 Plugging completed April 29, 1949 Reason for abandonment of well or producing formation dry hole

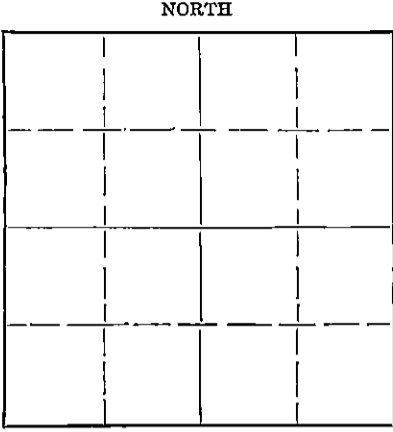

Locate well correctly on above Section Plat

Name of Conservation Agent who supervised plugging of this well C. D. Stough Producing formation Depth to top Bottom Total Depth of Well Feet Show depth and thickness of all water, oil and gas formations.

OIL, GAS OR WATER RECORDS

CASING RECORD

Table with 7 columns: Formation, Content, From, To, Size, Put In, Pulled Out. Rows include Surface Casing with measurements from 0 to 296 and 3642 feet.

Describe in detail the manner in which the well was plugged, indicating where the mud fluid was placed and the method or methods used in introducing it into the hole. Run 6 sacks cement from 3643 to 3605 feet Filled hole with mud from 3605 to 300 feet Run 15 sacks cement from 300 feet to 270 feet Filled hole with mud from 270 feet to 25 feet Capped with 10 sacks cement from 25 feet to cellar base.

(If additional description is necessary, use BACK of this sheet)

Correspondence regarding this well should be addressed to Westgate-Greenland Oil Company Address 1022 Union National Bank Building, Wichita 2, Kansas

STATE OF Kansas, COUNTY OF Sedgwick, ss. G. E. Bitler (employee of owner) of the above-described well, being first duly sworn on oath, says: That I have knowledge of the facts, statements, and matters herein contained and the log of the above-described well as filed and that the same are true and correct. So help me God. (Signature) G. E. Bitler 1022 Union National Bank Building, Wichita, Kas

SUBSCRIBED AND SWORN to before me this 9th day of May, 19 49. Esther Russell Notary Public.

My commission expires May 25, 1949

PLUGGING FILE SEC 32 T 21 R 16 BOOK PAGE 23 LINE 16

MAY 10 1949 5-1-49 STATE OF KANSAS OFFICE OF THE COMMISSIONER OF CORRELATION

COMPANY: Westgate Greenland Oil Company
 CONTRACTOR: Jackson Drilling Corp.
 FARM: Walker #1
 LOCATION: SE Corner of SW/4 Sec. 32-21-12W
 Stafford County, Kansas
 ELEVATION: 1870
 COMMENCED: March 24, 1949
 COMPLETED: April 7, 1949

0	to	215	Sand & shale
215	to	323	Shale & shells
323	to	735	Shale & red bed
735	to	800	Red Bed
800	to	1565	Shale & shells
1565	to	1685	Lime & shale
1685	to	1890	Lime
1890	to	1970	Lime & shale
1970	to	1985	Shale
1985	to	2220	Lime & shale
2220	to	3025	Shale
3025	to	3120	Shale & shells
3120	to	3160	Lime
3160	to	3245	Lime & shale
3245	to	3562	Lime
3562	to	3585	Lime rough
3585	to	3645	Lime

T. D.

5 1/2" - 15 1/2# casing set at 3642 feet cemented with 75 sacks cement
 8 5/8" - 32# casing set at 296 feet - Cemented with 350 sacks cement

Top Arbuckle - 3641

Dry

Measurements taken from top of derrick floor

C E R T I F I C A T E

I, Clare A. Stewart, do hereby certify that the above and foregoing is a true and correct copy of log of the Walker #1, Section 32-21-12W, Stafford County, Kansas, as reflected by files of the Jackson Drilling Corporation.

Clare A. Stewart
 Clare A. Stewart

Subscribed and sworn to before me, a Notary Public, within and for Johnson County, Kansas, this 19th day of April 1949.

PLUGGING
 FILE SEC 22-21-12W
 BOOK PAGE 93 LINE 16

Dorothy J. Wilson
 Dorothy J. Wilson

My Commission expires November 30, 1950

MAY 16 1949
 STATE OF KANSAS
 COMMISSIONER
 KANSAS

Faint, illegible text at the top of the page, possibly a header or introductory paragraph.


Main body of faint, illegible text, appearing to be several lines of a letter or report.

transmission of the... (mirrored text)

Additional faint, illegible text in the middle section of the page.

[Handwritten signature]

Faint, illegible text at the bottom of the main body.

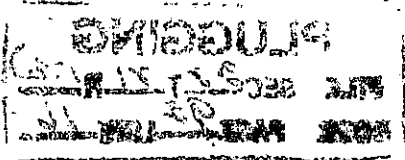

[Handwritten notes and scribbles]

Faint, illegible text at the very bottom of the page.