


STATE OF KANSAS  
STATE CORPORATION COMMISSION

Give All Information Completely  
Make Required Affidavit  
Mail or Deliver Report to:  
Conservation Division  
State Corporation Commission  
800 Bittling Building  
Wichita, Kansas

15-009-00297-1956  
WELL PLUGGING RECORD

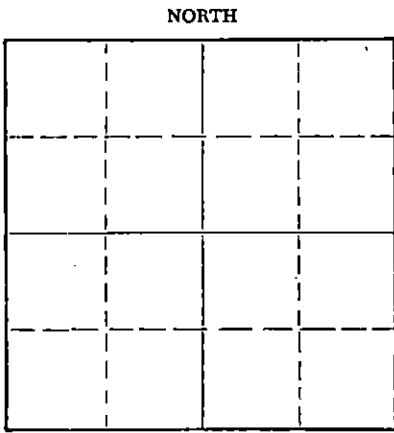

Locate well correctly on above  
Section Plat

Barton County, Sec. 29 Twp. 16 Rge. 12 (E) W (W)  
Location as "NE/CNW/SW" or footage from lines E/2 NW NE  
Lease Owner Frank G. Wood Drilling Co.  
Lease Name Laudick Well No. 1  
Office Address Box 619, Great Bend, Kansas  
Character of Well (completed as Oil, Gas or Dry Hole) Dry Hole  
Date well completed July 20 1956  
Application for plugging filed July 20 1956  
Application for plugging approved July 20 1956  
Plugging commenced July 20 1956  
Plugging completed July 20 1956  
Reason for abandonment of well or producing formation Dry

If a producing well is abandoned, date of last production 19  
Was permission obtained from the Conservation Division or its agents before plugging was commenced? Yes

Name of Conservation Agent who supervised plugging of this well R. M. Brundege  
Producing formation \_\_\_\_\_ Depth to top \_\_\_\_\_ Bottom \_\_\_\_\_ Total Depth of Well 3401 Feet  
Show depth and thickness of all water, oil and gas formations.

OIL, GAS OR WATER RECORDS

CASING RECORD

FORMATION	CONTENT	FROM	TO	SIZE	PUT IN	PULLED OUT
				8 5/8"	322'	None

Describe in detail the manner in which the well was plugged, indicating where the mud fluid was placed and the method or methods used in introducing it into the hole. If cement or other plugs were used, state the character of same and depth placed, from \_\_\_\_\_ feet to \_\_\_\_\_ feet for each plug set.

Filled hole with heavy mud to 320 feet, set bottom plug, dumped 20 sacks of cement on plug. Filled hole with mud to 35 feet, set top plug, dumped 10 sacks cement on plug. Cement filled to bottom of cellar.

15-009-00297-1956  
STATE CORPORATION COMMISSION  
07-27-56

(If additional description is necessary, use BACK of this sheet)  
Name of Plugging Contractor S & W Drilling Company  
Address Box 619, Great Bend, Kansas

STATE OF Kansas, COUNTY OF Barton  
Floyd W. Smith contractor <sup>ss.</sup>  
(employee of owner) or (owner or operator) of the above-described well, being first duly sworn on oath, says: That I have knowledge of the facts, statements, and matters herein contained and the log of the above-described well as filed and that the same are true and correct. So help me God.  
(Signature) Floyd W. Smith  
Great Bend, Kansas  
(Address)

SUBSCRIBED AND SWORN TO before me this 24th day of July, 19 56  
Dean E. Cooley  
Notary Public.

My commission expires April 29, 1956

PLUGGING  
FILE SEC 29 T 16 R 12W  
BOOK PAGE 82 LINE 40

WELL LOG

COMPANY Frank G. Wood Drilling Company  
 CONTRACTOR S & W Drilling Company  
 FARM Laudick #1  
 LOCATION E/2 NW NE of 29-16-12W  
 Barton County, Kansas  
 ELEVATION 1919 KB  
 SURFACE CASING 8 5/8" cemented @ 322' w/185 sacks Pozmix  
 COMMENCED July 8, 1956  
 COMPLETED July 20, 1956

FORMATION	DEPTH
Surface clay, sand and shale	322
Shale, shells and red bed	825
Anhydrite	865
Shale and shells	1610
Lime and shale	2440
Shale and shells	2600
Lime and shale	2745
Lime	2990
Lime and shale	3027
Lime and shale	3120
Lime	3382
Arbuckle	3401
Total Depth	3401

TOPS

Anhydrite	825 (-1094)
Heebner	3023 (-1104)
Lansing	3126 (-1207)
Arbuckle	3382 (-1463)

A F F I D A V I T

STATE OF Kansas, COUNTY OF Barton, 1956

I, Floyd W. Smith of the S & W DRILLING COMPANY being first duly sworn on oath, state; That I have knowledge of the facts, statements and matters herein contained and that the same are true and correct.

Floyd W. Smith  
 Partner

Subscribed and sworn to before me this 24th day of July, 1956

Dean E. Looney  
 Notary Public

My commission expires: April 29, 1957.

RECEIVED  
 CONSERVATION COMMISSION

JUL 27 1956

CONSERVATION DIVISION  
 Wichita, Kansas

PLUGGING  
 FILE SEC 29 T 16 R 12W  
 BOOK PAGE 82 LINE 40