

STATE OF KANSAS  
STATE CORPORATION COMMISSION


Give All Information Completely  
Make Required Affidavit  
Mail or Deliver Report to:  
Conservation Division  
State Corporation Commission  
212 No. Market  
Wichita, Kansas

WELL PLUGGING RECORD

Stafford County, Sec. 24 Twp. 21S Rge. 12W (W)

Location as "NE/CNW/SW" or footage from lines. 100' NE of NW SW SW  
Lease Owner Kansas Petroleum, Incorporated  
Lease Name Wilson Well No. 2  
Office Address 500 Insurance Bldg., Wichita, Kansas 67202  
Character of Well (completed as Oil, Gas or Dry Hole) Dry Hole  
Date well completed December 21, 1974  
Application for plugging filed December 21, 1974  
Application for plugging approved December 21, 1974  
Plugging commenced December 21, 1974  
Plugging completed December 21, 1974  
Reason for abandonment of well or producing formation Dry Hole

NORTH

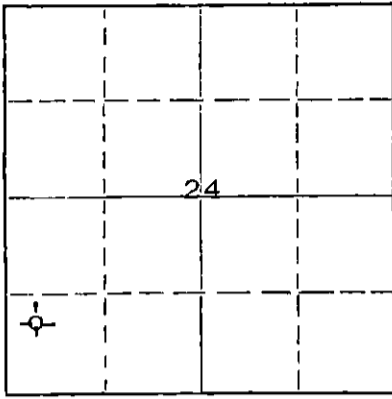

Locate well correctly on above Section Plat

If a producing well is abandoned, date of last production 19  
Was permission obtained from the Conservation Division or its agents before plugging was commenced? Yes

Name of Conservation Agent who supervised plugging of this well  
Producing formation Depth to top Bottom Total Depth of Well 3676 Feet  
Show depth and thickness of all water, oil and gas formations.

OIL, GAS OR WATER RECORDS

CASING RECORD

FORMATION	CONTENT	FROM	TO	SIZE	PUT IN	PULLED OUT
		0'	322'	8-5/8"	322'	None

Describe in detail the manner in which the well was plugged, indicating where the mud fluid was placed and the method or methods used in introducing it into the hole. If cement or other plugs were used, state the character of same and depth placed, from feet to feet for each plug set.

3676'-500' - Hole filled with mud.  
500'-496' - Plug  
496'-200' - Cement, 40 sacks.  
200'-196' - Plug  
196'-40' - Cement, 25 sacks.  
40'-36' - Plug  
36'-6' - Cement, 10 sacks. (Bottom of cellar)  
2 sacks cement in rat hole.

RECEIVED  
STATE CORPORATION COMMISSION

DEC 26 1974

CONSERVATION DIVISION  
Wichita, Kansas

12-20-1974

(If additional description is necessary, use BACK of this sheet)

Name of Plugging Contractor Halliburton Cementing Co.  
Address Great Bend, Kansas

STATE OF KANSAS COUNTY OF SEDGWICK, ss.  
John D. Knightley Agent (employee of owner) or (owner or operator) of the above-described well, being first duly sworn on oath, says: That I have knowledge of the facts, statements, and matters herein contained and the log of the above-described well as filed and that the same are true and correct. So help me God.

(Signature) [Signature]  
301 S. Broadway, Wichita, Kansas  
(Address)

SUBSCRIBED AND SWORN TO before me this 24th day of December, 1974

My commission expires March 12, 1975

[Signature] Notary Public.

15.185.20555.0000

Kansas Petroleum, Incorporated - Wilson #2  
100' NE of NW SW SW  
Sec. 24-21S-12W  
Stafford County, Kansas

Contractor: D. R. Lauck Oil Company, Inc.  
301 S. Broadway  
Wichita, Kansas 67202

Commenced: December 15, 1974  
Completed: December 21, 1974

Drillers Log

Sand	225
Red Bed	601
Anhydrite	622
Shale & Shells	1290
Shale & Lime	1890
Lime & Shale	2560
Shale	2795
Lime	3575
Shale	3676 RTD

RECEIVED  
STATE CORPORATION COMMISSION  
DEC 26 1974  
CONSERVATION DIVISION  
Wichita, Kansas