

For KCC Use:  
Effective Date: 11-5-03  
District #: 2  
SGA?  Yes  No

KANSAS CORPORATION COMMISSION  
OIL & GAS CONSERVATION DIVISION

NOTICE OF INTENT TO DRILL

Must be approved by the K.C.C. five (5) days prior to commencing well

RECEIVED

OCT 20 2003

KCC WICHITA

Form C-1  
December 2002  
Form must be Typed  
Form must be Signed  
All blanks must be Filled

Expected Spud Date NOVEMBER 4 2003  
month day year

Spot 20' S & 140' E OF  East  
C - W/2 - SE Sec. 16 Twp. 16 S. R. 7  West  
1300 feet from  N /  S Line of Section  
1840 feet from  E /  W Line of Section

OPERATOR: License # 3842  
LARSON OPERATING COMPANY  
A DIVISION OF LARSON ENGINEERING, INC.  
Address: 562 WEST HIGHWAY 4  
City/State/Zip: OLMITZ, KS 67564-8561  
Contact Person: TOM LARSON  
Phone: (620) 653-7368

Is SECTION X Regular        Irregular?  
(Note: Locate well on the Section Plat on Reverse Side)

CONTRACTOR: License # 9431  
Name: VONFELDT DRILLING, INC.

County: ELLSWORTH  
Lease Name: REED Well #: 1-16  
Field Name: WILDCAT

Is this a Prorated / Spaced Field?  Yes  No

Target Formation(s): LANSING

Nearest Lease or unit boundary: 800'

Ground Surface Elevation: 1585' feet MSL

Water well within one-quarter mile:  Yes  No

Public water supply well within one mile:  Yes  No

Depth to bottom of fresh water: 120'

Depth to bottom of usable water: 180'

Surface Pipe by Alternate:  1  2

Length of Surface Pipe Planned to be set: 250'

Length of Conductor pipe required: NONE

Projected Total Depth: 2800'

Formation at Total Depth: LANSING

Water Source for Drilling Operations:

Well  Farm Pond Other DRILLING CONTRACTOR

DWR Permit #:       

(Note: Apply for Permit with DWR )

Will Cores Be Taken?  Yes  No

If yes, proposed zone:       

Well Drilled For:  Oil  Enh Rec  Gas  OWWO  Seismic; # of Holes         Other         
Well Class:  Infield  Pool Ext.  Wildcat  Other         
Type Equipment:  Mud Rotary  Air Rotary  Cable

If OWWO: old well information as follows:

Operator       

Well Name:       

Original Completion Date:        Original Total Depth:       

Directional, Deviated or Horizontal wellbore?  Yes  No

If yes, true vertical depth:       

Bottom Hole Location:       

KCC DKT#:       

AFFIDAVIT

The undersigned hereby affirms that the drilling, completion and eventual plugging of this well will comply with K.S.A. 55-101, et. seq. It is agreed that the following minimum requirements will be met:

1. Notify the appropriate district office **prior** to spudding of well;
2. A copy of the approved Notice of Intent to Drill **shall be** posted on each drilling rig;
3. The minimum amount of surface pipe as specified below **shall be set** by circulating cement to the top; in all cases surface pipe **shall be set** through all unconsolidated materials plus a minimum of 20 feet into the underlying formation;
4. If the well is a dry hole, an agreement between the operator and the district office on plug length and placement is necessary **prior to plugging**;
5. The appropriate district office will be notified before well is either plugged or production casing is cemented in;
6. If an ALTERNATE II COMPLETION, production pipe shall be cemented from below any usable water to surface within **120 days** of spud date. Or pursuant to Appendix "B" - Eastern Kansas surface casing order #133,891-C, which applies to the KCC District 3 area, alternate II cementing must be completed within 30 days of spud date or the well shall be plugged. **In all cases, NOTIFY district office** prior to any cementing.

I hereby certify that the statements made herein are true and to the best of my knowledge and belief.

Date: 10/17/2003 Signature of Operator or Agent: Carol Larson Title: SECRETARY/TREASURER

Remember to:

- File Drill Pit Application (Form CDP-1) with Intent to Drill;
- File Completion Form ACO-1 within 120 days of spud date;
- File acreage attribution plat according to field proration orders;
- Notify appropriate district office 48 hours prior to workover or re-entry;
- Submit plugging report (CP-4) after plugging is completed;
- Obtain written approval before disposing or injecting salt water.

- If this permit has expired (See: authorized expiration date) please check the box below and return to the address below.

Well Not Drilled - Permit Expired

Signature of Operator or Agent:       

Date:       

For KCC use ONLY

API # 15 - 053-21120-00-00

Conductor pipe required NONE feet

Minimum surface pipe required 200 feet per Alt. 1 2

Approved by: DPW 10-31-03

This authorization expires: 4-30-04

(This authorization void if drilling not started within 6 months of effective date.)

Spud date:        Agent:       

Mail to: KCC - Conservation Division 130 S. Market - Room 2078, Wichita, Kansas 67202

16  
16  
7w

**IN ALL CASES PLOT THE INTENDED WELL ON THE PLAT BELOW**

*Plat of Acreage attributable to a well in a prorated or spaced field*

*If the intended well is in a prorated or spaced field, please fully complete this side of the form. If the intended well is in a prorated or spaced field complete the plat below showing that the well will be properly located in relationship to other wells producing from the common source of supply. Please show all the wells and within 1 mile of the boundaries of the proposed acreage attribution unit for gas wells and within 1/2 mile of the boundaries of the proposed acreage attribution unit for oil wells.*

API No. 15 - \_\_\_\_\_  
 Operator: LARSON OPERATING COMPANY  
A DIVISION OF LARSON ENGINEERING, INC.  
 Lease: REED  
 Well Number: 1-16  
 Field: WILDCAT

Location of Well: County: ELLSWORTH  
 \_\_\_\_\_ 1300 \_\_\_\_\_ feet from  N /  S Line of Section  
 \_\_\_\_\_ 1840 \_\_\_\_\_ feet from  E /  W Line of Section  
 Sec. 16 Twp. 16 S. R. 7  East  West

Is Section:  Regular or  Irregular

Number of Acres attributable to well: \_\_\_\_\_  
 QTR / QTR / QTR of acreage: \_\_\_\_\_ - \_\_\_\_\_ - \_\_\_\_\_



**If Section Is Irregular, locate well from nearest corner boundary.**

Section corner used:  NE  NW  SE  SW

**PLAT**

*(Show location of the well and shade attributable acreage for prorated or spaced wells.)  
 (Show footage to the nearest lease or unit boundary line.)*

ELLSWORTH COUNTY

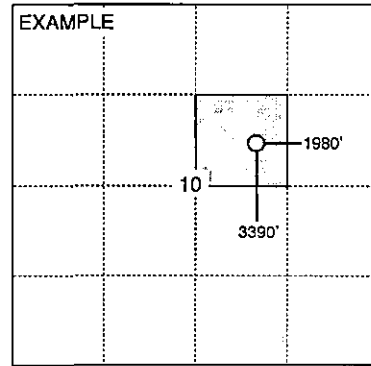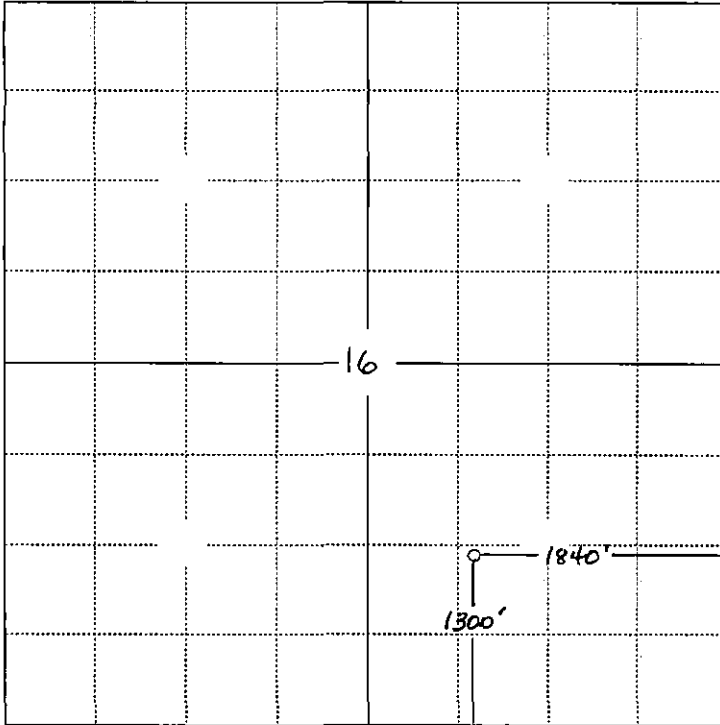

SEWARD CO.

**NOTE: In all cases locate the spot of the proposed drilling location.**

**In plotting the proposed location of the well, you must show:**

1. The manner in which you are using the depicted plat by identifying section lines, i.e. 1 section, 1 section with 8 surrounding sections, 4 sections, etc.
2. The distance of the proposed drilling location from the section's south / north and east / west.
3. The distance to the nearest lease or unit boundary line.
4. If proposed location is located within a prorated or spaced field a certificate of acreage attribution plat must be attached: (CO-7 for oil wells; CG-8 for gas wells).