

STATE OF KANSAS
STATE CORPORATION COMMISSION


WELL PLUGGING RECORD

Give All Information Completely
Make Required Affidavit
Mail or Deliver Report to:
Conservation Division
State Corporation Commission
212 No. Market
Wichita, Kansas

Stafford County. Sec. 24 Twp. 21s Rge. 13 ~~XIX~~ W (W)

Location as "NE/CNW/SW" or footage from lines NE SW SE
Lease Owner Bankoff Oil Company & Leben Drilling, Inc.
Lease Name McCrary Well No. 1
Office Address P. O. Box 486 - Great Bend, Kansas 67530
Character of Well (completed as Oil, Gas or Dry Hole) dry hole
Date well completed 6-6 19 68
Application for plugging filed 6-6 19 68
Application for plugging approved 6-6 19 68
Plugging commenced 6-6 19 68
Plugging completed 6-6 19 68
Reason for abandonment of well or producing formation dry hole

NORTH

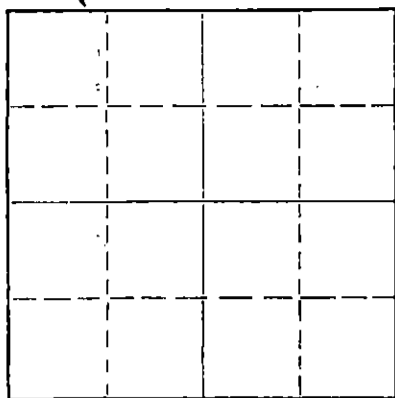

Locate well correctly on above
Section Plat

If a producing well is abandoned, date of last production _____ 19____
Was permission obtained from the Conservation Division or its agents before plugging was commenced? Yes

Name of Conservation Agent who supervised plugging of this well Ralph Warren - Pratt, Kansas
Producing formation _____ Depth to top _____ Bottom _____ Total Depth of Well 3715 Feet
Show depth and thickness of all water, oil and gas formations.

OIL, GAS OR WATER RECORDS

CASING RECORD

FORMATION	CONTENT	FROM	TO	SIZE	PUT IN	PULLED OUT
				8 5/8"	282.53	None

Describe in detail the manner in which the well was plugged, indicating where the mud fluid was placed and the method or methods used in introducing it into the hole. If cement or other plugs were used, state the character of same and depth placed, from _____ feet to _____ feet for each plug set.

Mud to 280' plug 1/2 hulls 25 skx cem thru d.p.
Mud to 40' 1/2 Hulls plug - 10 sks - 2 in rat hole

RECEIVED
STATE CORPORATION COMMISSION
JUN 14 1968
CONSERVATION DIVISION
Wichita, Kansas

(If additional description is necessary, use BACK of this sheet)

Name of Plugging Contractor Leben Drilling, Inc.
Address P. O. Box 486 - Great Bend, Kansas 67530

STATE OF Kansas, COUNTY OF Barton, ss.

Leslie Kite

(employee of owner) or (owner or operator) of the above-described

well, being first duly sworn on oath, says: That I have knowledge of the facts, statements, and matters herein contained and the log of the above-described well as filed and that the same are true and correct. So help me God.

(Signature) Leslie Kite

P. O. Box 486 - Great Bend, Kansas 67530
(Address)

SUBSCRIBED AND SWORN to before me this 12th day of June, 19 68

Ulanda Nichols

Ulanda Nichols

Notary Public.

My commission expires April 1, 1971

COMPANY
 CONTRACTOR
 FARM
 LOCATION
 COMMENCED
 COMPLETED

Bankoff Oil Company
 LEBEN DRILLING, INC.
 MC CRARY #1
 NE SW SE Section 24-21s-13w
 Stafford County, Kansas
 5-28-68
 6-5-68

0	205	Sand
205	265	Shale
265	704	Red Bed
704	721	Anhydrite
721	1465	Shale
1465	1755	Shale and Lime
1755	2255	Lime and Shale
2255	2850	Shale and Lime
2850	3270	Lime and Shale
3270	3465	Lime
3465	3590	Lime and Chert
3590	3630	Lime
3630	3715	Arbuckle
	3715	RTD - D & A

RECEIVED
 STATE CORPORATION COMMISSION
 JUN 14 1968
 CONSERVATION DIVISION
 Wichita, Kansas

8 5/8" New 20# Surface Casing - Set @ 290' with 250 sx common 2% cc

I, Leslie Kite, do hereby certify that the above and foregoing is a true and correct copy of the log of the McCrary #1, located NE SW SE of Section 24, Township 21 South, Range 13 West, Stafford County, Kansas, as reflected by the records of Leben Drilling, Inc.

Leslie Kite
 Leslie Kite

STATE OF KANSAS)
) SS
 COUNTY OF BARTON)

Subscribed and sworn to and before me, a Notary Public, in and for Barton County, Kansas, this 12th day of June, 1968.

Ulanda Nichols
 Ulanda Nichols

My Commission Expires
 April 1, 1971