


WELL PLUGGING RECORD

Give All Information Completely
Make Required Affidavit
Mail or Deliver Report to
Conservation Division
State Corporation Comm.
245 North Water
Wichita, KS 67202

Stafford County, Sec. 24 Twp. 21S Rge. 13W E/W
Location as "NE/CNW/SW" or footage from lines
SE SE NE
Lease Owner Arrowhead Petroleum, Inc.
Lease Name Schmalian Well No. #1
Office Address P.O. Box 8287-Munger Station, Wichita, Ks.
Character of Well (Completed as Oil, Gas or Dry Hole)
Dry Hole

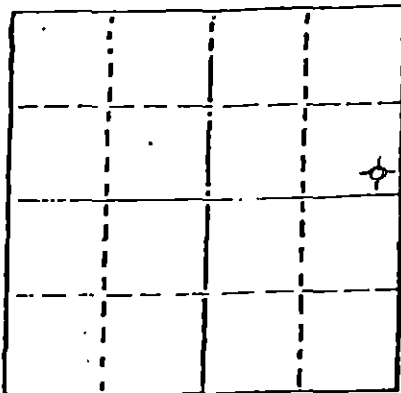

Date Well completed November 30 1982
Application for plugging filed November 30 1982
Application for plugging approved November 30 1982
Plugging commenced November 30 1982
Plugging completed November 30 1982
Reason for abandonment of well or producing formation
Dry Hole

If a producing well is abandoned, date of last production
N/A 19

Was permission obtained from the Conservation Division or
its agents before plugging was commenced? Yes

Name of Conservation Agent who supervised plugging of this well J. H. Metz
Producing formation _____ Depth to top _____ Bottom _____ Total Depth of Well 3615'
Show depth and thickness of all water, oil and gas formations.

OIL, GAS OR WATER RECORDS

CASING RECORD

FORMATION	CONTENT	FROM	TO	SIZE	PUT IN	PULLED OUT
Sand				8 5/8"	250'	none

Describe in detail the manner in which the well was plugged, indicating where the mud fluid
was placed and the method or methods used in introducing it into the hold. If cement or other
plugs were used, state the character of same and depth placed, from _____ feet to
_____ feet for each plug-set.

1020' 50 SX
330' 50 SX
40' 10 SX
RH 10 SX
water well 5 SX
50 - 50 POZ
2% gel 3% ccl

(If additional description is necessary, use BACK of this sheet)

Name of Plugging Contractor Allied Cementing

STATE OF Kansas COUNTY OF Sedgwick, ss.
Paul A. Seymour, III (employee of owner) or (owner or operator)

of the above-described well, being first duly sworn on oath, says: That I have knowledge of
the facts, statements, and matters herein contained and the log of the above-described well
is filed and that the same are true and correct. So help me God.

(Signature) Paul A. Seymour, III
Paul A. Seymour, III Box 8287-Munger Station
(Address) Wichita, Ks.

SUBSCRIBED AND SWORN TO before me this 4th day of December, 1982

LaDonna F. Landrum
Notary Public.

commission expires August 18, 1984

LaDonna F. Landrum
NOTARY PUBLIC
STATE OF KANSAS
My Appl. Exp. _____
RECEIVED
DEC 15 1982
CONSERVATION DIVISION
Wichita, Kansas