

STATE OF KANSAS
STATE CORPORATION COMMISSION

WELL PLUGGING RECORD

RECEIVED
MAR 10 1955
BRUNSON DRILLING CO., INC.

Give All Information Completely
Make Required Affidavit
Mail or Deliver Report to:
Conservation Division
State Corporation Commission
800 Bittling Building
Wichita, Kansas

Stafford

County, Sec. 24, Twp. 21S, Rge. 21E, S. 15W (E) (W)

Location as "NE/CNWxSWx" or footage from lines NE NW NE

Lease Owner Brunson Drilling Co., Inc.

Lease Name Batman Well No. 1

Office Address 333 First Nat'l. Bank - Wichita, Kansas

Character of Well (completed as Oil, Gas or Dry Hole)

Date well completed 19

Application for plugging filed 19

Application for plugging approved 19


Plugging commenced March 1 1955

Plugging completed March 5 1955

Reason for abandonment of well or producing formation

If a producing well is abandoned, date of last production 19

Was permission obtained from the Conservation Division or its agents before plugging was commenced? Yes

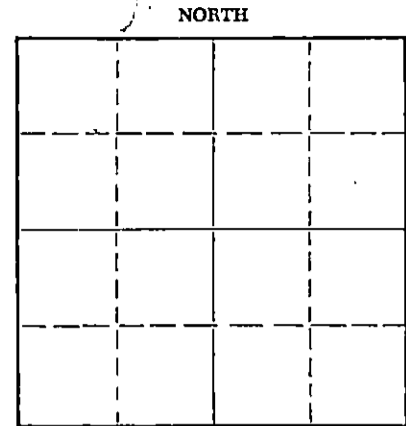

Locate well correctly on above Section Plat

Name of Conservation Agent who supervised plugging of this well Merle Rives

Producing formation Depth to top Bottom Total Depth of Well 3632 Feet

Show depth and thickness of all water, oil and gas formations.

OIL, GAS OR WATER RECORDS

CASING RECORD

FORMATION	CONTENT	FROM	TO	SIZE	PUT IN	PULLED OUT
				8-5/8"	250'	None
				5-1/2"	3618'	2492'

Describe in detail the manner in which the well was plugged, indicating where the mud fluid was placed and the method or methods used in introducing it into the hole. If cement or other plugs were used, state the character of same and depth placed, from feet to feet for each plug set.

Hole was plugged back to 3510' and casing was perforated from 3312' to 3317'. Filled hole with sand from 3510' to 3300' and ran 5 sacks of cement. Pumped in 20 sacks of mud. Bailed mud to 250', set a 10' rock bridge and ran 20 sacks of cement. Mudded hole to 35' and ran 10 sacks of cement on top. Plugging completed.

(If additional description is necessary, use BACK of this sheet)

Name of Plugging Contractor West Supply Co., Inc.
Address Chase, Kansas

STATE OF Kansas COUNTY OF Sedgwick, ss.
I, Ralph B. M. Laughlin (employee of owner) or (owner or operator) of the above-described well, being first duly sworn on oath, says: That I have knowledge of the facts, statements, and matters herein contained and the log of the above-described well as filed and that the same are true and correct. So help me God.

(Signature) Ralph B. M. Laughlin
1333 First Nat'l Bank (Address)

SUBSCRIBED AND SWORN TO before me this 21 day of March, 1955

My commission expires Mar 31, 1958
Notary Public.

PLUGGING
FILE SEC 24 T. 21 S. 15W
BOOK PAGE 110 LINE 15

PAM-KAR DRILLING CO.
WICHITA, KANSAS

Well: Batman # 1

NE NW NE
Sec. 24-21S-13W
Stafford CountyCommenced Rd 1-24-54
Completed Rd 2-5-54Elevation 1868 DF
1870 KBCasing: 281' 8 5/8" OD 2 1/4# 8 Rnd thd
3618' 5 1/2" OD 1 1/4# 8 Rnd thd

Contractor: Pam-Kar

STRATA	DEPTH	TOPS
Surface soil & clay	12	Heebner 3139-1269
Sand & gravel	190	Toronto 3157-1287
Shale & sand	240	Brown Lime 3267-1397
Red Bed & shale	255	Lansing 3285-1415
Red Bed	705	Simpson 3541-1671
Anhydrite	725	Arbuckle 3578-1708
Shale & shells	1185	
Salt & shale	1305	
Shale	1500	
Broken Lime	2100	
Shale & lime	3070	
Lime & shale	3582	
Lime	3602	
Arbuckle Lime	3632	
Total Depth	3632	

I hereby certify that the above is a true and correct log of said well as reflected by the daily drilling reports.

PAM-KAR DRILLING COMPANY, INC.
BY

Ralph B. McLaughlin
Ralph B. McLaughlin, Sec. Treas.

Signed and sworn to in my presence this 21st day of March, 1955, by Ralph B. McLaughlin, Secretary-Treasurer of the Pam-Kar Drilling Company, Inc., a corporation in the State of Kansas.

Danna L. Riley
Notary Public

My commission expires December 31, 1958.

PLUGGING
FILE SEC 24 T 21 R 13 W
BOOK PAGE 10 LINE 15