


STATE OF KANSAS
STATE CORPORATION COMMISSION

Give All Information Completely
Make Required Affidavit
Mail or Deliver Report to:
Conservation Division
State Corporation Commission
211 No. Broadway
Wichita, Kansas

WELL PLUGGING RECORD

STAFFORD County, Sec. 23 Twp. 21s Rge. 13 (E) (W)

Location as "NE/CNW/SW" or footage from lines SE NW SE
Lease Owner PETROLEUM, INC.,
Lease Name HALL "Q" Well No. 1
Office Address ROUTE #2, GREAT BEND, KANSAS
Character of Well (completed as Oil, Gas or Dry Hole) DRY HOLE
Date well completed SEPTEMBER 1 19 65
Application for plugging filed SEPTEMBER 1 19 65
Application for plugging approved SEPTEMBER 1 19 65
Plugging commenced SEPTEMBER 1 19 65
Plugging completed SEPTEMBER 1 19 65
Reason for abandonment of well or producing formation NO PRODUCIBLE ZONE

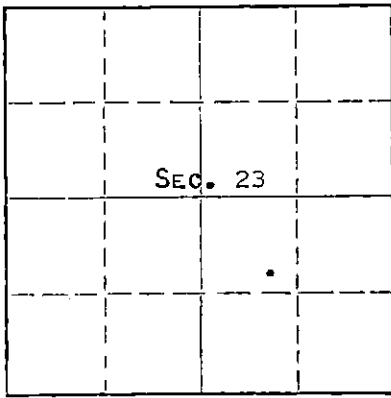

Locate well correctly on above Section Plat

If a producing well is abandoned, date of last production NONE 19
Was permission obtained from the Conservation Division or its agents before plugging was commenced? YES

Name of Conservation Agent who supervised plugging of this well ARCHIE ELVING
Producing formation _____ Depth to top _____ Bottom _____ Total Depth of Well 3685' Feet
Show depth and thickness of all water, oil and gas formations.

OIL, GAS OR WATER RECORDS

CASING RECORD

FORMATION	CONTENT	FROM	TO	SIZE	PUT IN	PULLED OUT
				8-5/8"	225'	NONE

Describe in detail the manner in which the well was plugged, indicating where the mud fluid was placed and the method or methods used in introducing it into the hole. If cement or other plugs were used, state the character of same and depth placed, from _____ feet to _____ feet for each plug set.

USED PUMP TRUCK TO PUMP HEAVY MUD INTO HOLE, TOOK 250# PRESSURE TO BREAK FORMATION.
FOLLOWED BY WOODEN PLUG AND PUMPED 80 SACKS CEMENT W/300# PRESSURE ON TOP OF PLUG TO BASE OF WELL CELLAR. HELD PRESSURE OVERNIGHT.

RECEIVED
STATE CORPORATION COMMISSION
SEP 10 1965
CONSERVATION DIVISION
Wichita, Kansas

(If additional description is necessary, use BACK of this sheet)

Name of Plugging Contractor GARVEY DRILLING CO.
Address R.R. #2, GREAT BEND, KANSAS

STATE OF KANSAS, COUNTY OF BARTON, ss.
MONTE CHADD (employee of owner) or (owner or operator) of the above-described well, being first duly sworn on oath, says: That I have knowledge of the facts, statements, and matters herein contained and the log of the above-described well as filed and that the same are true and correct. So help me God. MONTE CHADD, DIST. PROD. SUPT.

(Signature) *Monte Chadd*
R.R. #2, GREAT BEND, KANSAS
(Address)

SUBSCRIBED AND SWORN TO before me this 8TH day of SEPTEMBER, 19 65

Richard H. Dumbler
Notary Public.

My commission expires MAY 28, 1969

WELL LOG

15.185.30116.0000

COMPANY Petroleum, Inc.

SEC. 23 T21S R. 13W

FARM Hall

NO. Q-1

LOC. SE NW SE


TOTAL DEPTH 3685'

COUNTY Stafford

COMM. 8-23-65

COMP. 8-31-65

CONTRACTOR Garvey Drilling Company

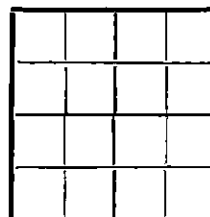

CASING 8 5/8" @ 225' w/225 sx

ELEVATION 1871' KB

PRODUCTION D & A

FIGURES INDICATE BOTTOM OF FORMATIONS

160' Clay and Sand
 225' Shale
 300' Shale and Shells
 730' Red Bed and Shale
 745' Anhydrite
 865' Shale
 1630' Shale and Shells
 2375' Lime and Shale
 2975' Shale and Lime
 3395' Lime and Shale
 3685' Lime
 3685' RTD

RECEIVED
STATE CORPORATION COMMISSION

SEP 10 1965

CONSERVATION DIVISION
Wichita, Kansas

State of Kansas }
 County of Barton } SS

I, Sam N. Stephens of Garvey Drilling Company

upon oath state the above and foregoing is a true and correct copy of the log of the Hall Q-1 well.

Sam N. Stephens

Subscribed and sworn to before me this 7th day of September 19 65

My Commission Expires: May 28, 1969

Richard H. Dumbke
NOTARY PUBLIC