

STATE OF KANSAS
STATE CORPORATION COMMISSION

WELL PLUGGING RECORD

Give All Information Completely
Make Required Affidavit
Mail or Deliver Report to:
Conservation Division
State Corporation Commission
800 Biting Building
Wichita, Kansas

Stafford County. Sec. 23 Twp. 21S Rge. 13W (E) W (W)

Location as "NE/CNW*SW*" or footage from lines G NW/4 NE/4 SE/4

Lease Owner Derby Oil Co.

Lease Name Hall Well No. 1

Office Address P. O. Box 1930, Wichita, Kansas

Character of Well (completed as Oil, Gas or Dry Hole) Dry

Date well completed February 28 19 53

Application for plugging filed February 28 19 53

Application for plugging approved February 28 19 53


Plugging commenced February 28 19 53

Plugging completed February 28 19 53

Reason for abandonment of well or producing formation Dry

If a producing well is abandoned, date of last production _____ 19 _____

Was permission obtained from the Conservation Division or its agents before plugging was commenced? Yes

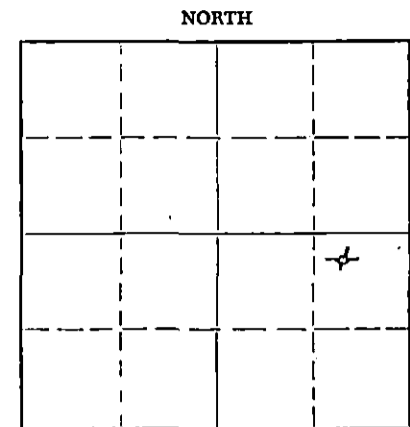

Locate well correctly on above Section Plat

Name of Conservation Agent who supervised plugging of this well M. A. Rives

Producing formation _____ Depth to top _____ Bottom _____ Total Depth of Well 3742 Feet

Show depth and thickness of all water, oil and gas formations.

OIL, GAS OR WATER RECORDS

CASING RECORD

FORMATION	CONTENT	FROM	TO	SIZE	PUT IN	PULLED OUT
		0'	312'	8 5/8"	312'	None

Describe in detail the manner in which the well was plugged, indicating where the mud fluid was placed and the method or methods used in introducing it into the hole. If cement or other plugs were used, state the character of same and depth placed, from _____ feet to _____ feet for each plug set.

From 3742' - 301 1/2' - Heavy Rotary Mud
301 1/2' - 300' - Wooden Plug
300' - 238' - 20 Sacks cement
238' - 36 1/2' - Heavy Rotary Mud
36 1/2' - 35' - Wooden Plug
35' - 6' - 10 Sacks Cement
6' - Surface - Gellar

STATE CORPORATION COMMISSION
MAR 10 1953
3-10-1953
CONSERVATION DIVISION
Wichita, Kansas

(If additional description is necessary, use BACK of this sheet)

Name of Plugging Contractor Glenn W. Peel
Address P. O. Box 359 Hoisington, Kansas

STATE OF Kansas, COUNTY OF Barton, ss. Glenn W. Peel (employee of owner) or (owner or operator) of the above-described well, being first duly sworn on oath, says: That I have knowledge of the facts, statements, and matters herein contained and the log of the above-described well as filed and that the same are true and correct. So help me God. GLENN W. PEEL

(Signature) BY: [Signature]
P. O. BOX 359
HOISINGTON, KANSAS
(Address)

SUBSCRIBED AND SWORN TO before me this 3rd day of March, 19 53

Marion M. Herbert
Notary Public.

My commission expires June 4, 1955

PLUGGING
FILE SEC 23 T 21 R 1324
BOOK PAGE 81 LINE 36

DRILLER'S LOG

Company: Derby Oil Co.

C NW/4 NE/4 SE/4
Sec. 23, Twp. 21S Rge. 13W

Farm: Hall Well No. 1

Total Depth: 3742'

County: Stafford,
Kansas

Comm: 2-14-53 Comp: 2-28-53

Contractor: Glenn W. Peel

Elevation:

Casing: 8 5/8" - 312' - cem.

Production: Dry

Figures below indicate bottom of formations:

Surface Clay & water sands	0 -	100
Red Bed		190
Shale & Red Bed		315
Shale & shells		714
Anhydrite		745
Shale		790
Shale & Shells		1625
Shale		1765
Shale & Lime		2035
Lime		2140
Lime & Shale		2905
Lime		2985
Lime & Shale		3105
Lime		3205
Lime & Shale		3300
Lime		3645
Conglomerate & Arbuckle		3655
Arbuckle		3742
Total Depth		3742

This is to certify that the above information is, to the best of our knowledge true and correct.

GLENN W. PEEL

BY: *Glenn W. Peel*

SUBSCRIBED AND SWORN to before me this 3rd day of March, 1953.

My commission expires June 4, 1955
Marion M. Hubert
Notary Public

RECEIVED
CONSERVATION COMMISSION
MAR 10 1953
CONSERVATION DIVISION
Wichita, Kansas

PLUGGING
FILE SEC 23 T 21 R 132
BOOK PAGE 81 LINE 36