

DEC 6 1957

STATE OF KANSAS  
STATE CORPORATION COMMISSION

WELL PLUGGING RECORD

Give All Information Completely  
Make Required Affidavit  
Mail or Deliver Report to:  
Conservation Division  
State Corporation Commission  
800 Bitting Building  
Wichita, Kansas

Stafford

County. Sec. 23 Twp. 21 Rge. 13 (#) W (W)

Location as "NE/CNW\*SW\*" or footage from lines. NW-SW-SW

Lease Owner D. R. Lauck Oil Co. Inc.

Lease Name Hall

Well No. 2

Office Address 301 South Broadway Wichita, Kansas

Character of Well (completed as Oil, Gas or Dry Hole) Dry

Date well completed 11-9- 19 57

Application for plugging filed 11-18- 19 57

Application for plugging approved 11-20- 19 57


Plugging commenced 11-21- 19 57

Plugging completed 11-26- 19 57

Reason for abandonment of well or producing formation Dry

If a producing well is abandoned, date of last production 19

Was permission obtained from the Conservation Division or its agents before plugging was commenced? Yes

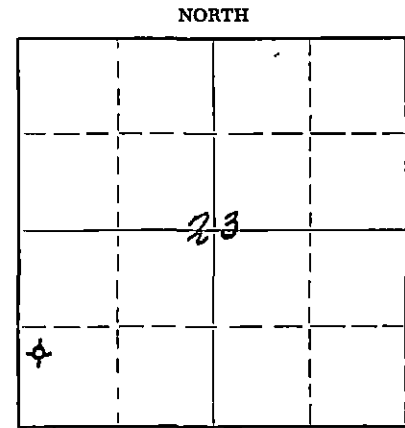

Locate well correctly on above Section Plat

Name of Conservation Agent who supervised plugging of this well Mr. Truan

Producing formation Arbuckle Depth to top 3667 Bottom 3712 Total Depth of Well 3712 Feet

Show depth and thickness of all water, oil and gas formations.

OIL, GAS OR WATER RECORDS

CASING RECORD

FORMATION	CONTENT	FROM	TO	SIZE	PUT IN	PULLED OUT
Lansing	Dry	3321	3541	10 3/4	253'	None
Viola	Dry	3581	3610	5 1/2	3669	3141
Simpson	Dry	3610	3667			
Arbuckle	Dry	3667	3712			

Describe in detail the manner in which the well was plugged, indicating where the mud fluid was placed and the method or methods used in introducing it into the hole. If cement or other plugs were used, state the character of same and depth placed, from \_\_\_\_\_ feet to \_\_\_\_\_ feet for each plug set.

3712 to 3700 Sand Bridge  
 3700 to 3675 5 Sx Cement  
 3675 to 250 Mud  
 250 to 235 Rock Bridge  
 235 to 175 30 Sx Cement  
 175 to 20 Mud  
 20 to Cellar 10 Sx Cement

12-9-1957

STATE CORPORATION COMMISSION

DEC 7 1957

(If additional description is necessary, use BACK of this sheet);  
Name of Plugging Contractor R. & S. Pipe Pulling Co.  
Address Box 192 Ellinwood, Kansas

STATE OF Kansas, COUNTY OF Sedgwick, ss.  
H. E. Wolfe (employee of owner) or (owner or operator) of the above-described well, being first duly sworn on oath, says: That I have knowledge of the facts, statements, and matters herein contained and the log of the above-described well as filed and that the same are true and correct. So help me God.

(Signature) [Signature]  
Wichita Kansas (Address)

SUBSCRIBED AND SWORN TO before me this 6 day of December 19 57

My commission expires Sept. 14, 1959

[Signature] Notary Public.

PLUGGING  
FILE SEC 23 T. 21 R. 13W  
BOOK PAGE 62 LINE 25

D. K. Lauck Oil Company, Inc.

Hall #2

NW ~~SW~~ SW Sec. 23-21S-13W  
Stafford County, KansasCommenced: July 5, 1957  
Completed: July 17, 1957Casing Record: 253' 10 3/4" cem.w/200 sacks  
3669' 5 1/2" cem.w/100 sacks

Elevation: GR 1868; DF 1870; KB 1872

Drillers LogTops

sand & clay	120
shale & shells	280
red bed	700
shale & shells	1380
salt & shale	1565
lime & shale	1725
lime	1985
lime & shale	3005
lime	3195
Douglas	3306
Brown Lime	3315
Lansing	3320
Lime	3530
Lime & chert	3611
Simpson	3651
shale & lime	3672
Arbuckle Lime	3682

RTD

Heebner	3177-1305
Brown Lime	3305-1433
Lansing Kansas City	3321-1449
Base Kansas City	3541-1669
Conglomerate	3572-1700
Viola	3581-1709
Simpson	3610-1738
Arbuckle	3667-1795
Rotary Total Depth	3682-1810

DST #1 (M-D) 3323-3355 open 1 hr, fair  
steady blow 1 hr; recov. 550'  
salt water; IFP 85#; FFP 295#  
BHP 770#, 20 min;DST #2 (M-D) 3360-3400 open 1 hr; fair  
steady blow 1 hr; recov. 585'  
salt water; IFP 110#; FFP 370#;  
BHP 1115#, 20 min.DST #3 (M-D) 3667-3670 tool plugged-  
no test;DST #4 (M-D) 3668-3672 Packer failure,  
no test;DST #5 3671-3677 open 30 min;  
recov. 55' rotary mud-  
BHP 380# in 20 min.DST #6 (M-D) 3676-3682 RTD open 30 min.  
weak blow 8 min. recov.  
25' mud; flushed tool;  
BHP 32#, 20 min.RECEIVED  
STATE CORPORATION COMMISSION

NOV 20 1957

CONSERVATION DIVISION  
Topeka, Kansas

## PLUGGING

FILE SEC. 23 T. 21 R. 13W  
BOOK PAGE 62 LINE 25