


STATE OF KANSAS  
STATE CORPORATION COMMISSION

15.185.20791.0000

WELL PLUGGING RECORD

Give All Information Completely  
Make Required Affidavit  
Mail or Deliver Report to  
Conservation Division  
State Corporation Comm.  
245 North Water  
Wichita, KS 67202

Stafford County. Sec. 31 Twp. 21 Rge. 13 ~~EW~~  
Location as "NE/CNW $\frac{1}{4}$ SW $\frac{1}{4}$ " or footage from lines  
SW SE NE  
Lease Owner Icer Addis  
Lease Name Nuss Well No. # 1  
Office Address P. O. Drawer 8038 Wichita, Kansas 67208  
Character of Well (Completed as Oil, Gas or Dry Hole)  
Dry Hole

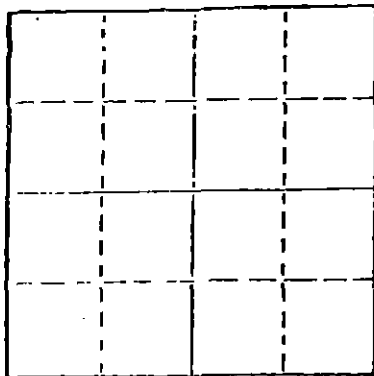

Locate well correctly on above  
Section Plot

Date Well completed 1-15 1978  
Application for plugging filed 1-15 1978  
Application for plugging approved 1-15 1978  
Plugging commenced 10:30 A.M. 1-15 1978  
Plugging completed 11:00 A.M. 1-15 1978  
Reason for abandonment of well or producing formation  
Dry hole

If a producing well is abandoned, date of last production 19

Was permission obtained from the Conservation Division or  
its agents before plugging was commenced? yes

Name of Conservation Agent who supervised plugging of this well Bill Owens  
Producing formation \_\_\_\_\_ Depth to top \_\_\_\_\_ Bottom \_\_\_\_\_ Total Depth of Well 3755'  
Show depth and thickness of all water, oil and gas formations.

OIL, GAS OR WATER RECORDS

CASING RECORD

FORMATION	CONTENT	FROM	TO	SIZE	PUT IN	PULLED OUT

Describe in detail the manner in which the well was plugged, indicating where the mud fluid was placed and the method or methods used in introducing it into the hold. If cement or other plugs were used, state the character of same and depth placed, from \_\_\_\_\_ feet to \_\_\_\_\_ feet for each plug set.

Bottom Plug at 540' W/40 sacks 50/50 Pozmix 2% Gel.  
Middle Plug at 300' W/25 sacks " " "  
Top plug at 40' W/ 1/2 sack hulls and 12 SX Pozmix 2% Gel.  
3 sacks in rat hole

RECEIVED  
STATE CORPORATION COMMISSION

JAN 20 1978

(If additional description is necessary, use BACK of this sheet)

Name of Plugging Contractor \_\_\_\_\_ CONSERVATION DIVISION  
Wichita, Kansas

STATE OF Kansas COUNTY OF Barton, ss.  
Wayne Dobbs (employee of owner) or (owner or operator)  
of the above-described well, being first duly sworn on oath, says: That I have knowledge of the facts, statements, and matters herein contained and the log of the above-described well as filed and that the same are true and correct. So help me God.

(Signature) Wayne Dobbs  
Wayne Dobbs

SUBSCRIBED AND SWORN TO before me this 17th day of January, 19 78

Bessie M. DeWerff  
Bessie M. DeWerff Notary Public.

My commission expires 5-21-81

BESSIE M. DEWERFF  
STATE NOTARY PUBLIC  
BARTON COUNTY, KANSAS  
MY APPT. EXP. 5-21-81

DRILLERS WELL LOG

L. D. DRILLING COMPANY - CONTRACTOR

ICER ADDIS - OPERATOR

NUSS # 1

ELEV. 1915 KB

SW SE NE 31-21-13

T. D. 3755

STAFFORD COUNTY, KANSAS

CASING

8-5/8" set at 308'

CEMENT

W/250 sx. 60/40 Pozmix, 2% Gel, 3% CC

COMMENCED: 1-7-78

COMPLETED: 1-15-78

FORMATION

Surface Clay

Sand

Shale

Red Bed

Anhy.

Shale &amp; Shells

Lime &amp; Shale

Shale

Lime &amp; Shale

Dolomite

DEPTH

0 - 30

30 - 285

285 - 500

500 - 794

794 - 830

830 - 1700

1700 - 3248

3248 - 3252

3252 - 3746

3746 - 3755

TOPS

Anhy.

Heeb.

Toronto

Douglas

B/Lime

Lansing

B K/C

Viola

Simp.

Arb.

R.T.D.

794

3248

3272

3288

3376

3386

3590

3657

3704

3746

3755

RECEIVED  
STATE CORPORATION COMMISSION

JAN 20 1978

CONSERVATION DIVISION  
Wichita, KansasAFFIDAVITState of Kansas County of BartonI, Wayne Dobbs of the L. D. Drilling Company

being first duly sworn on oath, State: That I have knowledge of the facts statements and matters herein contained and that the same are true and correct.

Wayne Dobbs  
Wayne DobbsSubscribed and sworn to before me on this 17th day of January 1978

My commission expires: 5-20-81

Bessie M. DeWerff  
Notary Public: Bessie M. DeWerff

BESSIE M. DEWERFF
STATE NOTARY PUBLIC
BAKTON COUNTY, KANSAS
MY APPT. EXP. 5-20-81