


STATE OF KANSAS  
STATE CORPORATION COMMISSION

WELL PLUGGING RECORD

Give All Information Completely  
Make Required Affidavit

Mail or Deliver Report to:  
Conservation Division  
State Corporation Commission  
800 E. 10th Building  
Wichita, Kansas

NORTH

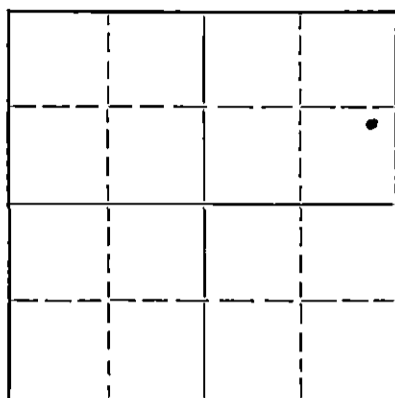

Locate well correctly on above  
Section Plat

Stafford County, Sec. 31 Twp. 21 Rge. 13 (E) W (W)  
Location as "NE/CNW 1/4 SW 1/4" or footage from lines NE-SE-NE  
Lease Owner PETROLEUM, Inc.  
Lease Name WETIG "A" Well No. 3  
Office Address 305 East Third, Wichita, Kansas  
Character of Well (completed as Oil, Gas or Dry Hole) Dry Hole  
Date well completed July 9 19 53  
Application for plugging filed July 13 19 53  
Application for plugging approved July 19 19 53  
Plugging commenced July 20 19 53  
Plugging completed July 25 19 53  
Reason for abandonment of well or producing formation  
No Producing zones.  
If a producing well is abandoned, date of last production 19  
Was permission obtained from the Conservation Division or its agents before plugging was commenced? Yes

Name of Conservation Agent who supervised plugging of this well M. A. Rives  
Producing formation --- Depth to top 3,744' Bottom --- Total Depth of Well 3,804' Feet  
Show depth and thickness of all water, oil and gas formations.

OIL, GAS OR WATER RECORDS

CASING RECORD

| Formation | Content | From   | To     | Size   | Put In | Pulled Out |
|-----------|---------|--------|--------|--------|--------|------------|
| Arbuckle  | Water   | 3,750' | 3,754' | 8-5/8" | 303'   | None       |
|           |         |        |        | 5-1/2" | 3,802' | 3,180'     |

Describe in detail the manner in which the well was plugged, indicating where the mud fluid was placed and the method or methods used in introducing it into the hole. If cement or other plugs were used, state the character of same and depth placed, from --- feet to --- feet for each plug set.

(Drilled cement out to 3,776')

Filled hole from 3,776' to 3,740' with crushed rock and from 3,740' to 3,700' with cement. Mudded up to 270' and set rock bridge. Cemented from 270' to 190' and then mudded up to 35'. Filled hole to base of cellar with cement.

(If additional description is necessary, use BACK of this sheet)

Correspondence regarding this well should be addressed to PETROLEUM, Inc.  
Address Rural Route 2, Great Bend, Kansas

STATE OF Kansas, COUNTY OF Sedgewick, ss.  
Paul R. Shivel (employee of owner) or (owner or operator) of the above-described well, being first duly sworn on oath, says: That I have knowledge of the facts, statements, and matters herein contained and the log of the above-described well as filed and that the same are true and correct. So help me God.

(Signature) *Paul R. Shivel*  
Rural Route 2, Great Bend, Kansas  
(Address)

SUBSCRIBED AND SWORN TO before me this 4th day of August, 19 53

My Commission Expires Oct. 13, 1954

My commission expires

23-5091-s

8-50-10M

RECEIVED  
STATE CORPORATION COMMISSION

AUG - 7 1953

CONSERVATION DIVISION  
Wichita, Kansas

PLUGGING  
FILE SEC 31 T 21 R 13W  
BOOK PAGE 114 LINE 26

DRILLER'S LOG WETIG NO. 3

Petroleum, Inc., Operator

Section 31, Twp. 21S, Rge. 13W

Garvey Drilling Company, Contractor

Location: NE SE NE

Drilling Commenced: June 15, 1953  
Drilling Completed: June 26, 1953

County: Stafford County, Kansas

R.T.D.: 3804'

Casing Record: 8 5/8" @ 303' w/225 sax  
5 1/2" @ 3802' w/75 sax

Production: Arbuckle

Figures below indicate bottom of formation:

|      |                |
|------|----------------|
| 40   | Surface soil   |
| 200  | Sand & Shale   |
| 215  | Hard Sand      |
| 303  | Sand & Shale   |
| 340  | Shale & Shells |
| 790  | Red Bed        |
| 820  | Anhydrite      |
| 1740 | Shale & Shells |
| 3391 | Lime & Shale   |
| 3570 | Lime           |
| 3659 | Lime & Shale   |
| 3700 | Chert          |
| 3745 | Shale          |
| 3804 | Lime           |

Tops:

|             |              |
|-------------|--------------|
| Heebner:    | 3249 (-1333) |
| Brown Lime: | 3377 (-1461) |
| Lansing:    | 3386 (-1470) |
| Arbuckle:   | 3745 (-1829) |

DST, 3756-61, open 1 hr., rec. 30' muddy oil, 30' very heavily oil cut mud, 30' heavily oil cut mud, 30' muddy water (bottom hole pressure failed to record)

3804' R.T.D.

I hereby certify that this is a true and correct log of the above mentioned well.

PETROLEUM, INC.

*By* W. W. T. H.

STATE OF KANSAS }  
COUNTY OF SEDGWICK }

SS:

**PLUGGING**  
 PLK SEC 31 T 21 R 13W  
 BOOK PAGE 14 LINE 26

Subscribed to and sworn to before me, a Notary Public, in said County and State, this 6th day of June, 1953.

STATE CORPORATION COMMISSION

AUG - 7 1953

*Charlotte Heidman*  
Notary Public  
Wichita, Kansas

My commission expires: October 13, 1954.