

STATE OF KANSAS  
STATE CORPORATION COMMISSION


Give All Information Completely  
Make Required Affidavit  
Mail or Deliver Report to:  
Conservation Division  
State Corporation Commission  
800 Bittling Building  
Wichita, Kansas

WELL PLUGGING RECORD

Stafford County, Sec. 31 Twp. 21 Rge. 13 (E) (W)

Location as "NE/CNW/SW" or footage from lines NW NW NE  
Lease Owner Petroleum, Inc.  
Lease Name Wetlg Well No. 2  
Office Address 305 East Third, Wichita, Kansas  
Character of Well (completed as Oil, Gas or Dry Hole) Dry Hole  
Date well completed August 17, 1952  
Application for plugging filed August 17, 1952  
Application for plugging approved August 17, 1952  
Plugging commenced August 17, 1952  
Plugging completed August 17, 1952  
Reason for abandonment of well or producing formation Dry Hole

NORTH

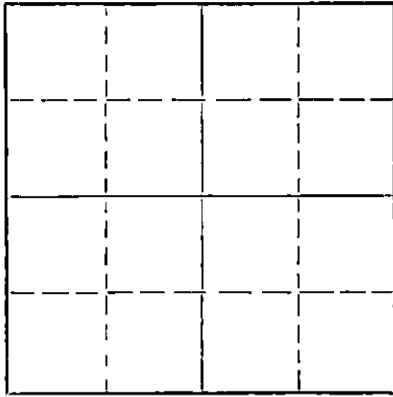

Locate well correctly on above  
Section Plat

If a producing well is abandoned, date of last production 19  
Was permission obtained from the Conservation Division or its agents before plugging was commenced? Yes

Name of Conservation Agent who supervised plugging of this well Mr. M. A. Rives  
Producing formation Depth to top Bottom Total Depth of Well 3644 Feet  
Show depth and thickness of all water, oil and gas formations.

OIL, GAS OR WATER RECORDS

CASING RECORD

FORMATION	CONTENT	FROM	TO	SIZE	PUT IN	PULLED OUT
				8 5/8"	192'	None

Describe in detail the manner in which the well was plugged, indicating where the mud fluid was placed and the method or methods used in introducing it into the hole. If cement or other plugs were used, state the character of same and depth placed, from feet to feet for each plug set.

Mudded up to 192' and set wooden plug at  
192'. Cemented and displaced 20 sacks  
cement through drill pipe onto plug at  
192'. Mudded up to 35' and set second wooden  
plug. Filled hole to bottom of well cellar  
with 10 sacks cement.

AUG 28 1952 8-28-1962

CONSERVATION DIVISION  
Wichita, Kansas

(If additional description is necessary, use BACK of this sheet)  
Name of Plugging Contractor Garvey Drilling Company  
Address R. R. #2, Great Bend, Kansas

STATE OF KANSAS; COUNTY OF SEDGWICK, ss.  
Charlotte Weidman (employee of owner) of the above-described  
well, being first duly sworn on oath, says: That I have knowledge of the facts, statements, and matters herein contained and the log of the  
above-described well as filed and that the same are true and correct. So help me God.

(Signature) Charlotte Weidman  
35 East Third, Wichita 2, Kansas  
(Address)

SUBSCRIBED AND SWORN TO before me this 21st day of August, 1952

My commission expires October 27, 1952  
Marjorie Bradshaw  
Notary Public.

PLUGGING  
FILE SEC 31 T 21 R 130  
BOOK PAGE 38 LINE 28

DRILLER'S LOG WETIG NO. 2

Petroleum, Inc., Operator  
Garvey Drilling Company, Contractor  
Drilling Commenced: August 7, 1952  
Drilling Completed: August 17, 1952  
Casing Record: 8 5/8" @ 192' w/175 sax

Section 31, Twp. 21S, Rge. 13W  
Location: NW NW NE  
County: Stafford County, Kansas  
R.T.D.: 3644'  
Production: D & A

Figures below indicate bottom of formation:

110 Sand  
180 Sand Stone & Gravel  
227 Shale & Shells  
335 Shale & Sand Streaks  
560 Red Bed & Shells  
802 Red Bed  
830 Anhydrite  
1260 Shale & Shells  
1550 Shells & Shale  
3174 Lime & Shale  
3284 Lime  
3379 Lime & Shale  
3610 Lime  
3644 Lime & Shale  
3644' R.T.D.

Tops:

Heebner: 3247 (-1329)  
Brown Lime: 3373 (-1455)  
Lansing: 3382 (-1464)  
DST #1, 3398-3422, open 1 hour, rec.  
100' slightly oil and gas cut mud,  
250# BHP.  
DST #2, 3423-80, open 1 hour, recovered  
50' very slightly oil cut mud  
60' watery mud, 1250# BHP.  
DST #3, 3518-3569, open 1 hour, rec.  
30' mud, 0# BHP.

I hereby certify that this is a true and correct log of the above mentioned well.

PETROLEUM, INC.

By W W Fisher

STATE OF KANSAS )  
COUNTY OF SEDGWICK )

RECEIVED  
STATE CORPORATION COMMISSION  
SS: AUG 28 1952  
CONSERVATION DIVISION  
Wichita, Kansas

Subscribed to and sworn to before me, this 26th day of August, 1952.

PLUGGING  
FILE SEC 31 T 21 R 13W  
BOOK PAGE 38 LINE 28

Charlotte Heisner  
Notary Public

My commission expires: October 13, 1954.