


WELL PLUGGING RECORD

Give All Information Completely
Make Required Affidavit
Mail or Deliver Report to:
Conservation Division
State Corporation Commission
800 Bittling Building
Wichita, Kansas

NORTH

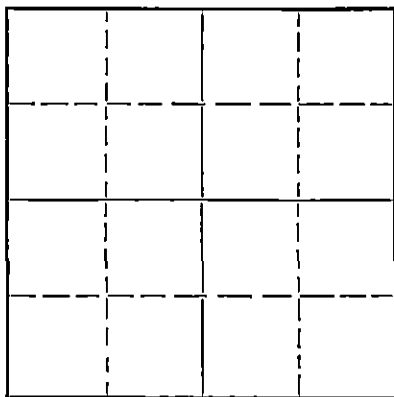

Locate well correctly on above Section Plat

Stafford County. Sec. 31 Twp. 21 Rge. 13 (E) (W)
Location as "NE/CNW $\frac{1}{4}$ SW $\frac{1}{4}$ " or footage from lines NW/4 NW/4 NE/4
Lease Owner Petroleum, Inc.
Lease Name Watig Well No. 1
Office Address 100 Derby Bldg., Wichita, Kansas
Character of Well (completed as Oil, Gas or Dry Hole) Dry Hole
Date well completed September 29, 19 51
Application for plugging filed September 29, 19 51
Application for plugging approved September 29, 19 51
Plugging commenced September 29, 19 51
Plugging completed September 29, 19 51

Reason for abandonment of well or producing formation Dry Hole
If a producing well is abandoned, date of last production 19
Was permission obtained from the Conservation Division or its agents before plugging was commenced? Yes

Name of Conservation Agent who supervised plugging of this well Mr. Charles Stough
Producing formation Depth to top Bottom Total Depth of Well 375.4 Feet
Show depth and thickness of all water, oil and gas formations.

OIL, GAS OR WATER RECORDS

CASING RECORD

Formation	Content	From	To	Size	Put In	Pulled Out
				8 5/8"	255'	None

Describe in detail the manner in which the well was plugged, indicating where the mud fluid was placed and the method or methods used in introducing it into the hole. If cement or other plugs were used, state the character of same and depth placed, from feet to feet for each plug set.

Wooden plug set at 240'. Cemented
and displaced through drill pipe 15
sax cement. Filled hole with heavy
mud to 35'. Placed second plug at 35'.
Filled hole to bottom of cellar with
10 sax cement.

(If additional description is necessary, use BACK of this sheet)

Correspondence regarding this well should be addressed to Petroleum, Inc.
Address 100 Derby Bldg., Wichita, Kansas

STATE OF KANSAS, COUNTY OF SEDGWICK, ss.
Eric H. Jager (employee of owner) of the above-described well,
being first duly sworn on oath, says: That I have knowledge of the facts, statements, and matters herein contained and the log of the above-described well as filed and that the same are true and correct. So help me God.

(Signature) Eric H. Jager
100 Derby Bldg., Wichita, Kansas (Address)

SUBSCRIBED AND SWORN TO before me this 2nd day of October, 19 51
Charlotte Herdman Notary Public.

My commission expires October 13, 1954
28-5091-s 8-50-10M

PLUGGING
FILE SEC 31 T 21 R 13W
BOOK PAGE 113 LINE 5

PETROLEUM, INC.

#1 Wetig NW NW NE 31-21S-13W
Stafford County, Kansas

0	40	Sand
40	94	Sand & shale
94	109	Iron pyrite
109	255	Shale & shells
255	755	Sand, red shale
755	800	Red bed
800	840	Anhydrite
840	1215	Red bed & shale
1215	1520	Salt & shells
1520	2225	Shale & lime
2225	2375	Shale
2375	2480	Shale & lime
2480	2610	Shale & shells
2610	2785	Shale
2785	2985	Shale & lime
2985	3275	Lime
3275	3360	Lime & shale
3360	3660	Lime
3660	3680	Chert
3680	3710	Chert, lime, shale
3710	3740	Lime & shale
3740	3749	Lime
3749	3754	Lime & chert
	3754	Total Depth
		D&A

COMMENCED: 9/15/51
COMPLETED: 9/30/51

CASING RECORD

Set 8-5/8" surface casing at
255' with 175 sacks cement.

STATE OF KANSAS)
) SS
COUNTY OF SEDGWICK)

I hereby affirm that the above and foregoing is a true and correct copy of
the log of the #1 Wetig located NW NW NE 31-21S-13W, Stafford County, Kansas.

ANSCHUTZ DRILLING COMPANY

BY: *H. R. Jensen*

Subscribed and sworn to before me this 3rd day of October, 1951.

Patricia Oberker
Notary Public

My commission expires January 21, 1954.

PLUGGING
FILE SEC 31-21-13W (32)
BOOK PAGE 113 LINE 5

RECEIVED
STATE CORPORATION COMMISSION
OCT. X 5 1951
CONSERVATION DIVISION
Wichita, Kansas