


WELL PLUGGING RECORD

Give All Information Completely  
Make Required Affidavit  
Mail or Deliver Report to:  
Conservation Division  
State Corporation Commission  
800 Bitting Building  
Wichita, Kansas

Stafford County, Sec. 31 Twp. 21 Rge. (E) 13 (W)  
Location as "NE/CNW $\frac{1}{4}$ /SW $\frac{1}{4}$ " or footage from lines C SW SW SW  
Lease Owner Pickrell Drilling Company  
Lease Name Wetig Well No. 1  
Office Address 705 4th National Bank Building, Wichita 2, Kansas  
Character of Well (completed as Oil, Gas or Dry Hole) Dry hole  
Date well completed 8-7 19 52  
Application for plugging filed 8-7 19 52  
Application for plugging approved 8-7 19 52  
Plugging commenced 8-7 19 52  
Plugging completed 8-7 19 52  
Reason for abandonment of well or producing formation D & A

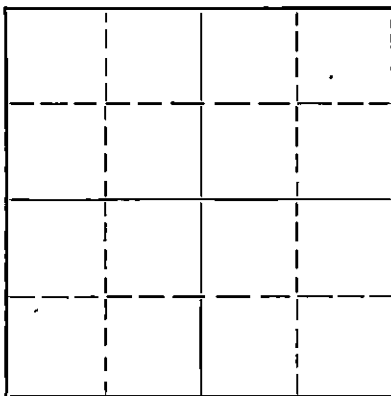

Locate well correctly on above  
Section Plat

If a producing well is abandoned, date of last production 19...  
Was permission obtained from the Conservation Division or its agents before plugging was commenced? Yes

Name of Conservation Agent who supervised plugging of this well M. A. Rives  
Producing formation Depth to top Bottom Total Depth of Well 3769 Feet  
Show depth and thickness of all water, oil and gas formations.

OIL, GAS OR WATER RECORDS

CASING RECORD

Formation	Content	From	To	Size	Put In	Pulled Out
				8 5/8"	348'	None
				No oil string was run		

Describe in detail the manner in which the well was plugged, indicating where the mud fluid was placed and the method or methods used in introducing it into the hole. If cement or other plugs were used, state the character of same and depth placed, from... feet to... feet for each plug set.

Filled with heavy mud from 3768' to 300'. Set plug at 300' and cemented with 20 sacks cement. Filled with heavy mud to 35' & set plug and cemented with 10 sacks cement.

CONSERVATION COMMISSION  
AUG 26 1952

CONSERVATION DIVISION  
Wichita, Kansas

Name of Plugging Contractor Pickrell Drilling Company  
Address 705 4th. Nat'l. Bank Bldg.,  
Wichita 2, Kansas

STATE OF Kansas, COUNTY OF Sedgwick, ss.  
C. W. Sebitts (employee of owner) or (owner or operator) of the above-described well,

being first duly sworn on oath, says: That I have knowledge of the facts, statements, and matters herein contained and the log of the above-described well as filed and that the same are true and correct. So help me God

(Signature) [Signature]  
705 4th Nat'l. Bank Building, Wichita, Kans.  
(Address)

SUBSCRIBED AND SWORN TO before me this 25th day of August, 1952

[Signature] Notary Public.

My commission expires January 28, 1953  
PLUGGING  
FILE SEC 31 T 21 R 13  
PAGE 36 LINE 42

ROTARY DRILLING LOG

COMPANY: Pickrell Drlg. Company etal

Rotary Drilling Commenced 7-28-52

LOCATION: Well #1  
SW SW 31-21S-13W  
Stafford County, Kansas

Rotary Drilling Completed 8-7-52

CONTRACTOR: PICKRELL DRILLING COMPANY  
Wichita, Kansas

CASING RECORD: 348' of 8 5/8" 24# smls. casing set at 347' in a 12 1/4" hole, cemented with 22 1/2 sacks cement. Cement circulated.

No oil string was run. Filled with heavy mud from 3768' to 300'. Set plug at 300' & cemented with 20 sacks cement. Filled with heavy mud to 35' and set plug and cement with 10 sacks cement.

LOG

(Figures indicate bottom of formation - measurements from top of rotary bushing.)

Sand	205	Circulate for samples at	3437'
Sand Rock	225	" " "	3478'
Sand	316	" " "	3492'
Sand Rock	347	" " "	3580'
Red Bed & Sand	807	" " "	3678'
Anhydrite	840	" " "	3734'
Red bed, shale & shells	900	" " "	3764'
Shale & salt	1535	" " "	3769'
Shale & shells	1660		Lost mud at 3426' & 3435'
Lime & shale	1780		
Lime & shale	1925		
Shale lime	2145		
Shale & lime	2260		
Lime & shale	2280	SLM at 3389' - O.K.	
Shale & shells	2400		
Shale	2640		
Shale & lime	2785		
Lime & shale	2905		
Lime	3055		
Lime	3140		
Lime	3245		
Lime	3330		
Lime	3410		
Lime	3435		
Lime	3450		
Lime	3492		
Lime	3520		
Lime	3575		
Lime	3635		
Lime	3669		
Cherty Viola	3685		
Lime	3725		
Lime	3760		
Arbuckle	3764		
Arbuckle lime	3769	Total Depth	

The undersigned, C. W. Sebitts, Attorney-in-Fact for PICKRELL DRILLING COMPANY, hereby certifies in behalf of said Company, that the above is a true and correct log of the formation encountered in drilling the above well as reflected by the Daily Drilling Reports.

RECEIVED  
COMMISSION

PICKRELL DRILLING COMPANY

*[Signature]*  
Attorney-in-Fact

STATE OF KANSAS,  
COUNTY OF SEDGWICK

PLUGGING  
FILED  
Wichita, Kansas  
PAGE 36 LINE 4  
1952

On this 18th day of August, 1952, before me the undersigned, a Notary Public, in and for

the County and State aforesaid, personally appeared C. W. Sebitts, to me known to be the identical person who subscribed the name of PICKRELL DRILLING COMPANY to the foregoing instrument as its Attorney-in-Fact and acknowledged to me that he executed the same as his free and voluntary act and deed, and as the free and voluntary act and deed of such company, for the uses and purposes therein set forth.

Given under my hand and seal of office the day and year last above written.

My commission expires: Mar. 22, 1956

*[Signature]*  
Notary Public