


WELL PLUGGING RECORD

Give All Information Completely
Make Required
Mail or Delivery
Conservation
State Corporation Commission
211 North
Wichita

Stafford County, Sec. 21 Twp. 21S Rge. 14 (W)
Location as "NE/CNW/SW" or footage from lines C NW NW SE
Lease Owner Gulf Oil Corporation
Lease Name Bledsoe Heirs Well No. 1
Office Address Box 661, Tulsa, Oklahoma
Character of Well (completed as Oil, Gas or Dry Hole) Dry Hole
Date well completed 6-23 19 56
Application for plugging filed 1-10 19 58
Application for plugging approved 1-13 19 58
Plugging commenced 2-1 19 58
Plugging completed 2-11 19 58
Reason for abandonment of well or producing formation Dry Hole

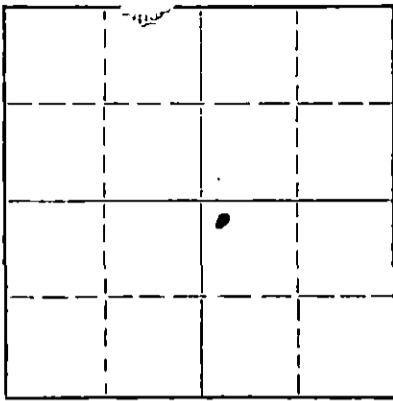

Locate well correctly on above Section Plat

If a producing well is abandoned, date of last production 19
Was permission obtained from the Conservation Division or its agents before plugging was commenced? Yes

Name of Conservation Agent who supervised plugging of this well J. Lewis Brock
Producing formation Depth to top Bottom Total Depth of Well 3865 Feet
Show depth and thickness of all water, oil and gas formations.

OIL, GAS OR WATER RECORDS

CASING RECORD

FORMATION	CONTENT	FROM	TO	SIZE	PUT IN	PULLED OUT
				8-5/8"	864'	0
				5-1/2"	3844'	2735'

Describe in detail the manner in which the well was plugged, indicating where the mud fluid was placed and the method or methods used in introducing it into the hole. If cement or other plugs were used, state the character of same and depth placed, from feet to feet for each plug set.

Filled with sand to 3690' and spotted 5 sx. cement. Filled with mud to 300'. Placed rock bridge and spotted 25 sx. cement to 240'. Mudded to 35', placed rock bridge, and capped with 10 sx. cement, filling into cellar.

RECEIVED
STATE CORPORATION COMMISSION

FEB 18 1958

CONSERVATION DIVISION
Wichita, Kansas

2-18-1958

(If additional description is necessary, use BACK of this sheet)
Name of Plugging Contractor C. E. Shull Casing Pulling Co.
Address Great Bend, Kansas

STATE OF Kansas, COUNTY OF Sedgwick, ss.
Thomas A. Trax (employee of owner) of the above-described well, being first duly sworn on oath, says: That I have knowledge of the facts, statements and matters herein contained and the log of the above-described well as filed and that the same are true and correct. So help me God.

(Signature) *Thomas A. Trax*

Box 2233, Wichita, Kansas
(Address)

SUBSCRIBED AND SWORN TO before me this 12th day of February, 1958

C. C. Lewis
Notary Public.

My commission expires 6-3-61

C. C. LEWIS, NOTARY PUBLIC

JRM:PF

PLUGGING
FILE SEC. 21 T. 21 R. 14
BOOK PAGE 75 11 3.0

For *Harvey*

BLEDSOE HEIRS NO. 1

15.185.11552.0000

C NW NW SE Section 21-21S-14W
Stafford County, Kansas
Gulf Oil Corporation

317

8-5/8" O. D. casing cemented at 864'
5-1/2" O. D. casing cemented at 3844'

Drilling commenced April 21, 1956
Drilling completed May 7, 1956

FROM	TO	FORMATION	REMARKS
0'	250'	Shale & sand	
250	305	Shale	
305	380	Dakota sand	
380	760	Red bed & shale	
760	859	Red bed	
859	889	Anhydrite	8-5/8" O. D. casing cemented with
889	950	Red bed & clay	175 sacks cement at 864'
950	1870	Shale & shells	670
1870	2055	Shale, sand & lime	
2055	2171	Shale & lime	
2171	2380	Shale	
2380	2550	Shale & lime streaks	
2550	2781	Shale	
2781	3030	Shale & lime	
3030	3135	Lime & shale	
3135	3275	Lime	
3275	3455	Shale & lime	
3455	3731	Lime	Coring 3695' - 3626-1/2'
3731	3737	Chert & shale	Coring 3627' - 3731'
3737	3772	Shale	Coring 3764' - 3772'
3772	3784	Shale & lime	
3784	3865	Lime	5-1/2" O. D. casing cemented with 175 sacks cement at 3844'

T.D. 3865'

PLUGGING

FILE SEC 21 T. 21 R. 44
BOOK PAGE 75 LINE 30

RECEIVED
STATE CORPORATION COMMISSION

JAN 11 1958

CONSERVATION DIVISION
Wichita, Kansas

