

15-009-00463-00-00


STATE OF KANSAS  
STATE CORPORATION COMMISSION

Form CP-4

Give All Information Completely  
Make Required Affidavit  
Mail or Deliver Report to:  
Conservation Division  
State Corporation Commission  
212 No. Market  
Wichita, Kansas 67202

WELL PLUGGING RECORD

Barton County. Sec. 1 Twp. 16 Rge. (E) 13 (W)  
Location as "NE/CNW/SW" or footage from lines SW NE NE  
Lease Owner Petroleum, Inc.  
Lease Name Rude Well No. 2  
Office Address Box 433, Great Bend, Kansas 67530  
Character of Well (completed as Oil, Gas or Dry Hole) oil  
Date well completed \_\_\_\_\_ 19\_\_\_\_  
Application for plugging filed March 24 1971  
Application for plugging approved \_\_\_\_\_ 19\_\_\_\_  
Plugging commenced April 15 1971  
Plugging completed April 22 1971  
Reason for abandonment of well or producing formation depleted

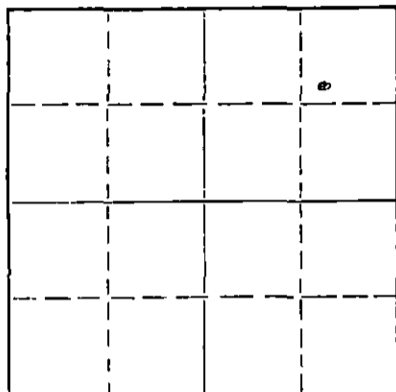

Locate well correctly on above  
Section Plat

If a producing well is abandoned, date of last production \_\_\_\_\_ 19\_\_\_\_  
Was permission obtained from the Conservation Division or its agents before plugging was commenced? yes

Name of Conservation Agent who supervised plugging of this well Donald Truan  
Producing formation \_\_\_\_\_ Depth to top \_\_\_\_\_ Bottom \_\_\_\_\_ Total Depth of Well 3390 Feet  
Show depth and thickness of all water, oil and gas formations.

OIL, GAS OR WATER RECORDS

CASING RECORD

FORMATION	CONTENT	FROM	TO	SIZE	PUT IN	PULLED OUT
		0	526'	8 5/8"	526'	none
		0	3222'	4 1/2"	3222'	1712.41

Describe in detail the manner in which the well was plugged, indicating where the mud fluid was placed and the method or methods used in introducing it into the hole. If cement or other plugs were used, state the character of same and depth placed, from \_\_\_\_\_ feet to \_\_\_\_\_ feet for each plug set.

Sanded back to 2900' and dumped 4 sacks of cement.

Set 20' rock bridge at 320'. Plugged well with 5 yards of ready mix cement.

RECEIVED  
STATE CORPORATION COMMISSION  
APR 27 1971  
CONSERVATION DIVISION  
Wichita, Kansas

(If additional description is necessary, use BACK of this sheet)  
Name of Plugging Contractor PIPE PULLERS, INC.  
Address Box 486, Ellinwood, Kansas 67526

STATE OF KANSAS, COUNTY OF BARTON, ss.  
Evelyn Roth (employee of owner) or (owner or operator) of the above-described well, being first duly sworn on oath, says: That I have knowledge of the facts, statements, and matters herein contained and the log of the above-described well as filed and that the same are true and correct. So help me God.

(Signature) Evelyn Roth  
Ellinwood, Kansas (Address)

SUBSCRIBED AND SWORN TO before me this 26th day of April, 1971

My commission expires Feb. 10, 1975

George A. Meyer  
Notary Public.


15-009-00463-00-00

Company- Petroleum Incorporated,  
 Farm- Rude No. 2

SEC. 1 T. 16 R. 13W  
 SW NE NE

Total Depth. 3390'  
 Comm. 2-14-1958 Comp. 2-23-1958  
 Shot or Treated.  
 Contractor. Gravey Drilling Co.,  
 Issued. 7-19-1958

County Barton  
 KANSAS

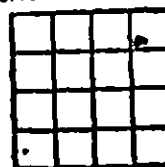

Elevation. 1896 BB.

Production. 57 BOPD/PHY FOT.

CASING:

8 5/8" @ 526' W/250 sks. cem.,  
 4 1/2" @ 3222' W/100 sks. cem.,

Figures Indicate Bottom of Formations.

surface sand & clay	80
sand & shale	435
shale & shells	830
Anhydrite	855
shale & shells	1750
lime & shale	2170
shale & shells	2725
lime & shale	2920
lime	3375
lime & shale	3390
Total Depth	

RECEIVED  
 STATE CORPORATION COMMISSION  
 MAR 25 1971  
 CONSERVATION DIVISION  
 Wichita, Kansas

TOPS SCOUT:

Anhydrite	830
Heebner	2989
Toronto	3006
Douglas	3025
Brown Lime	3078
Lansing	3088
Chert Conglomerate	3351
Quartz	3385