

STATE OF KANSAS
STATE CORPORATION COMMISSION

Form CP-4

Give All Information Completely
Make Required Affidavit
Mail or Deliver Report to:
Conservation Division
State Corporation Commission
212 No. Market
Wichita, Kansas 67202

WELL PLUGGING RECORD

Barton County, Sec. 1 Twp. 16 Rge. (E) 13 (W)

Location as "NE/CNW/SW" or footage from lines NW SW NE

Lease Owner Petroleum, Inc.

Lease Name Rude Well No. 3

Office Address Box 433, Great Bend, Kansas 67530

Character of Well (completed as Oil, Gas or Dry Hole) oil

Date well completed _____ 19__

Application for plugging filed March 24 1971

Application for plugging approved _____ 19__


Plugging commenced April 6 1971

Plugging completed April 13 1971

Reason for abandonment of well or producing formation depleted

If a producing well is abandoned, date of last production _____ 19__

Was permission obtained from the Conservation Division or its agents before plugging was commenced? yes

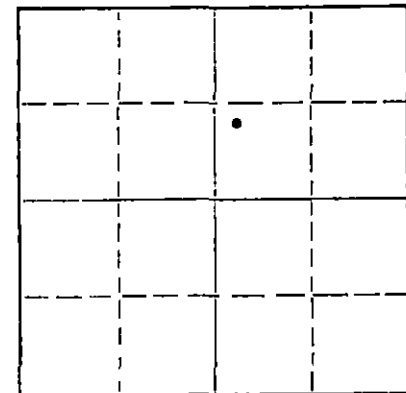

Locate well correctly on above Section Plat

Name of Conservation Agent who supervised plugging of this well Donald Truan

Producing formation _____ Depth to top _____ Bottom _____ Total Depth of Well 3325 Feet

Show depth and thickness of all water, oil and gas formations.

OIL, GAS OR WATER RECORDS

CASING RECORD

FORMATION	CONTENT	FROM	TO	SIZE	PUT IN	PULLED OUT
		0	545'	10 3/4"	545'	none
		0	3321'	7"	3321'	1756.03

Describe in detail the manner in which the well was plugged, indicating where the mud fluid was placed and the method or methods used in introducing it into the hole. If cement or other plugs were used, state the character of same and depth placed, from _____ feet to _____ feet for each plug set.

Sanded back to 2900' and dumped 6 sacks of cement.

Set 20' rock bridge at 320'. Plugged well with 6 yards of ready mix cement.

RECEIVED
STATE CORPORATION COMMISSION
APR 27 1971
CONSERVATION DIVISION
Wichita, Kansas

Name of Plugging Contractor PIPE PULLERS, INC. (If additional description is necessary, use BACK of this sheet)

Address Box 486, Ellinwood, Kansas 67526

STATE OF KANSAS, COUNTY OF BARTON, ss.
Evelyn Roth

(employee or operator) of the above-described well, being first duly sworn on oath, says: That I have knowledge of the facts, statements, and matters herein contained and the log of the above-described well as filed and that the same are true and correct. So help me God.

(Signature) Evelyn Roth

Ellinwood, Kansas

(Address)

SUBSCRIBED AND SWORN TO before me this 21 day of April, 1971

My commission expires Feb. 10, 1975

George A. Meyer
Notary Public.

WELL LOG BUREAU--KANSAS GEOLOGICAL SOCIETY
508 East Murdock, Wichita, Kansas

COPY


15-009-16147-00-00

Company. PETROLEUM, INC.
Farm. Rude No. 3

SEC. 1 T. 16 R. 13W
NW SW NE

Total Depth. 3325'
Comm. 6-20-58 Comp. 6-30-58
Shot or Treated.
Contractor. Garvey Drig. Co.
Issued. 1-10-59

County Barton
KANSAS

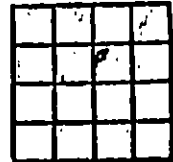

Elevation. 1901' RB

Production. 82 BOPD

CASING:

10 3/4" 545' cem w/325 sx.
7" 3321' cem w/150 sx.

Figures Indicate Bottom of Formations.

surface soil, sand & shale	285
shale & shells	613
shale	822
Anhydrite	864
shale & shells	1720
lime & shale	2230
shale & lime	2380
shale	2615
shale & lime	2742
lime	3250
shale & lime	3270
lime	3325
Total Depth	

TOPS: SCOUT	
Anhydrite	822
Topeka	2662
Heebner	2974
Toronto	2991
Douglas	3003
Brown Lime	3059
Lansing	3069
Base Kansas City	3254
Conglomerate	3262
Quartzite	3311

RECEIVED
STATE CORPORATION COMMISSION
MAR 25 1971
CONSERVATION DIVISION
Wichita, Kansas