


WELL PLUGGING RECORD

Give All Information Completely  
Make Required Affidavit  
Mail or Deliver Report to:  
Conservation Division  
State Corporation Commission  
211 No. Broadway  
Wichita, Kansas

BARTON CO, KANSAS County. Sec. 2 Twp. 16S Rge. 13W (E) (W)  
CE/2 E/2 NE/4

Location as "NE/CNW/SW" or footage from lines \_\_\_\_\_  
Lease Owner K & E & BELL & KRAVIS  
Lease Name RUDE 'E' Well No. 2  
Office Address 719 Union Center, Wichita 2, Kansas  
Character of Well (completed as O-I, Gas or Dry Hole) D & A  
Date well completed 1-30-59 19\_\_\_\_  
Application for plugging filed 1-30-59 19\_\_\_\_  
Application for plugging approved 1-30-59 19\_\_\_\_  
Plugging commenced 1-30-59 19\_\_\_\_  
Plugging completed 1-30-59 19\_\_\_\_  
Reason for abandonment of well or producing formation \_\_\_\_\_

NORTH

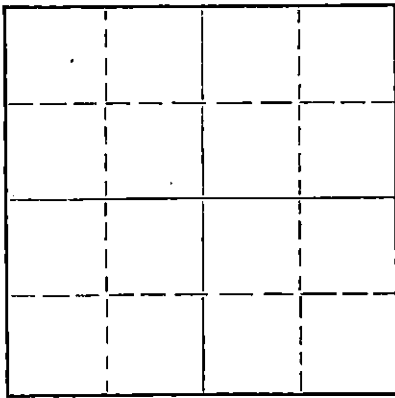

Locate well correctly on above  
Section Plat

If a producing well is abandoned, date of last production \_\_\_\_\_ 19\_\_\_\_  
Was permission obtained from the Conservation Division or its agents before plugging was commenced? yes

Name of Conservation Agent who supervised plugging of this well \_\_\_\_\_  
Producing formation \_\_\_\_\_ Depth to top \_\_\_\_\_ Bottom \_\_\_\_\_ Total Depth of Well 3375' Feet  
Show depth and thickness of all water, oil and gas formations.

OIL, GAS OR WATER RECORDS

CASING RECORD

FORMATION	CONTENT	FROM	TO	SIZE	PUT IN	PULLED OUT
				8-5/8"	357'	

Describe in detail the manner in which the well was plugged, indicating where the mud fluid was placed and the method or methods used in introducing it into the hole. If cement or other plugs were used, state the character of same and depth placed, from \_\_\_\_\_ feet to \_\_\_\_\_ feet for each plug set.

Fill with heavy mud to 350' set plug with 1/4 sx hulls & 25 sx cement thru drill pipe. Fill with heavy mud to 40' set solid bridge with 1/2 sx hulls and 10 sx cement to base of cellar.

Job Complete 1-30-59

RECEIVED  
STATE CORPORATION COMMISSION  
FEB 13 1959  
CONSERVATION DIVISION  
Wichita, Kansas

(If additional description is necessary, use BACK of this sheet)  
Name of Plugging Contractor K & E DRILLING, INC.  
Address 719 Union Center, Wichita 2, Kansas

STATE OF KANSAS, COUNTY OF SEDGWICK, ss.  
Dale Silcott (employee of owner) or (owner or operator) of the above-described well, being first duly sworn on oath, says: That I have knowledge of the facts, statements, and matters herein contained and the log of the above-described well as filed and that the same are true and correct. So help me God.

(Signature) Dale Silcott  
Dale Silcott of K & E DRILLING, INC.  
719 Union Center, Wichita 2, Kansas  
(Address)

SUBSCRIBED AND SWORN TO before me this 12th day of February, 1959

My commission expires August 11th, 1962.

Patricia M. Edwards, Notary Public.

PLUGGING  
FILE SEC. 2 T. 16 R. 13W  
BOOK PAGE 16 LINE 35

DRILLER'S LOG

OPERATOR: K & E DRILLING, INC. FARM NAME: #2 RUDE 'E'  
 719 Union Center  
 Wichita 2, Kansas LOCATION: CE/2 E/2 NE/4  
 Sec. 2-16S-13W  
 CONTRACTOR: Q K & E DRILLING, INC. Barton County, Ks.  
 719 Union Center  
 Wichita 2, Kansas COMMENCED: 1-22-59  
 COMPLETED: 1-30-59  
 CASING: 8-5/8" @ 357' (175 sx)  
 R.T.D. 3375' ELEVATION: 1904' KB  
 PRODUCTION: D & A

FORMATION RECORD

Clay & Shale	100
Shale & Shells	245
Sand	255
Shale & Shells	857
Anhydrite	892
Shale & Shells	1775
Lime & Shale	1955
Lime	2055
Shale & Lime	2255
Lime & Shale	2760
Lime	3375
R.T.D.	3375

CERTIFICATION

STATE OF KANSAS )  
 ) SS:  
 COUNTY OF SEDGWICK )

I, Dale Silcott of K & E DRILLING, INC., upon oath state that the above and foregoing is a true and correct copy of the log of the K & E #2 RUDE 'E' well.

*Dale Silcott*

Dale Silcott

Subscribed and sworn to before me this 12th day of February, 1959.

*Patricia M. Edwards*

Patricia M. Edwards, Notary Public

My commission expires: August 11th, 1962.

RECEIVED  
 STATE CORPORATION COMMISSION

FEB 13 1959

CONSERVATION DIVISION  
 WICHITA  
 DRILLING  
 FILE SEC. 2 T. 16 R. 13W  
 BOOK PAGE 16 LINE 35