

15-009-21695-00-00


STATE OF KANSAS  
STATE CORPORATION COMMISSION

WELL PLUGGING RECORD

Give All Information Completely  
Make Required Affidavit  
Mail or Deliver Report to  
Conservation Division  
State Corporation Comm.  
245 North Water  
Wichita, KS 67202

Barton County, Sec. 2 Twp. 16S Rge. 13WE/W  
Location as "NE/CNW/SW" or footage from lines  
SE NW NW

Lease Owner Arrowhead Petroleum, Inc.  
Lease Name Weeks Well No. 1  
Office Address Box 8287, Munger Station, Wichita, KS 67202  
Character of Well (Completed as Oil, Gas or Dry Hole)  
Dry Hole

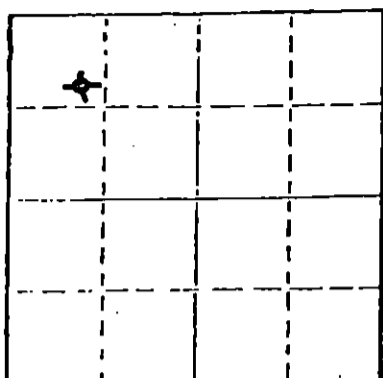

Locate well correctly on above  
Section Plot

Date Well completed 10-11-79 19  
Application for plugging filed 10-11-79 19  
Application for plugging approved 10-11-79 19  
Plugging commenced 10-11-79 19  
Plugging completed 10-11-79 19  
Reason for abandonment of well or producing formation  
Dry Hole

If a producing well is abandoned, date of last production  
N/A 19

Was permission obtained from the Conservation Division or  
its agents before plugging was commenced? yes

Name of Conservation Agent who supervised plugging of this well D. L. Rankin  
Producing formation Depth to top Bottom Total Depth of Well 335  
Show depth and thickness of all water, oil and gas formations.

OIL, GAS OR WATER RECORDS

CASING RECORD

FORMATION	CONTENT	FROM	TO	SIZE	PUT IN	PULLED OUT
Sand				8 5/8"	261'	None

Describe in detail the manner in which the well was plugged, indicating where the mud fluid was placed and the method or methods used in introducing it into the hold. If cement or other plugs were used, state the character of same and depth placed, from feet to feet for each plug set.

50 sx 510'  
25 sx 240'  
10 sx 40'  
3 sx RH

50 - 50 PAZ 4% gel

10-16-1979  
RECEIVED  
STATE CORPORATION COMMISSION  
OCT 16 1979  
CONSERVATION DIVISION  
Wichita, Kansas

(If additional description is necessary, use BACK of this sheet)

Name of Plugging Contractor Service Company

STATE OF Kansas COUNTY OF Sedgwick, ss.  
Paul A. Seymour, Jr. (employee of owner) or (owner or operator  
of the above-described well, being first duly sworn on oath, says: That I have knowledge of  
the facts, statements, and matters herein contained and the log of the above-described well  
as filed and that the same are true and correct. So help me God.

(Signature) Paul A. Seymour, Jr.  
Box 8287, Munger Station, Wichita, KS 67208  
(Address)

SUBSCRIBED AND SWORN TO before me this 15th day of October, 1979

Ruth M. Bassett  
Ruth M. Bassett Notary Public.

My commission expires May 30, 1983

15-009-21695-00-00

# BIG SPRINGS DRILLING, INC.

P.O. BOX 8287  
MUNGER STATION  
WICHITA, KANSAS 67208

SUITE 29 • 400 NORTH WOODLAWN • (316) 681-1732

October 15, 1979

## DRILLERS LOG

Re: Weeks No. 1  
SE NW NW  
Sec. 2- Twp 16s - Rq 13W  
Barton County, Kansas

OPERATOR: Arrowhead Petroleum, Inc.  
CONTRACTOR: Big Springs Drilling, Inc.  
COMMENCED: 10-6-79  
COMPLETED: 10-11-79

Surface Pipe: 261' of 8 5/8" w/175 sx Common 2% gel 3% ccl

0	261	Sand, Shale, Clay
261	846	Clay and Shale
846	881	Anhydrite
881	2945	Shale and Lime
2945	3355	Lime
3355		RTD

RECEIVED  
STATE CORPORATION COMMISSION

OCT 16 1979


CONSERVATION DIVISION  
Wichita, Kansas

We certify that the above and foregoing is a true and correct copy of the log on the # 1 Weeks located in Barton County, Kansas.

BIG SPRINGS DRILLING, INC.

  
Paul A. Seymour, Jr.

Subscribed and sworn to before me this 15th day of October, 1979.

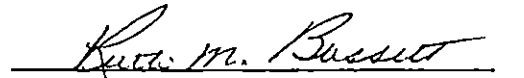  
Ruth M. Bassett Notary Public

My Commission Expires:

May 30, 1983