


Give All Information Completely
Make Required Affidavit
Mail or Deliver Report to:
Conservation Division
State Corporation Commission
211 No. Broadway
Wichita, Kansas

WELL PLUGGING RECORD

Barton County, Sec. 34 Twp. 16S Rge. 12W (XXXXXX)

Location as "NE/CNW4SW4" or footage from lines SE SW SE
Lease Owner Sam P. Wallingford, Inc. and Mayfield-Smith Drlg., Inc.
Lease Name Jenisch Well No. 1
Office Address 928 Union Center, Wichita, Kans.
Character of Well (completed as Oil, Gas or Dry Hole) Dry Hole
Date well completed October 14 19 64
Application for plugging filed " " 19 64
Application for plugging approved " " 19 64
Plugging commenced " " 19 64
Plugging completed " " 19 64
Reason for abandonment of well or producing formation
Oil in commercial quantities not found.
If a producing well is abandoned, date of last production - - - 19
Was permission obtained from the Conservation Division or its agents before plugging was commenced? Yes

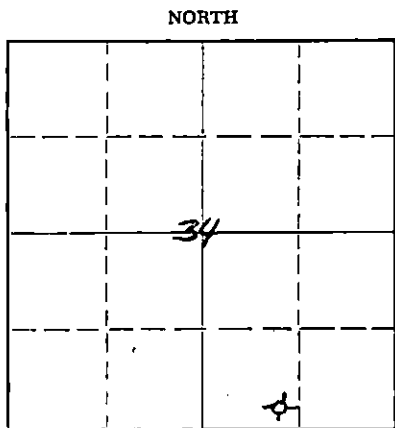

Locate well correctly on above Section Plat

Name of Conservation Agent who supervised plugging of this well Donald Truan, Russell, Kansas
Producing formation - - - Depth to top - - - Bottom - - - Total Depth of Well 3378 Feet
Show depth and thickness of all water, oil and gas formations.

OIL, GAS OR WATER RECORDS

CASING RECORD

FORMATION	CONTENT	FROM	TO	SIZE	PUT IN	PULLED OUT
				8 5/8"	200'	None

Describe in detail the manner in which the well was plugged, indicating where the mud fluid was placed and the method or methods used in introducing it into the hole. If cement or other plugs were used, state the character of same and depth placed, from - - - feet to - - - feet for each plug set.

Filled hole with heavy rotary mud to 400'. Set #1 plug with 20 Sks. Cement.
Set #2 Plug @ 190' With 20 Sks. Cement, #3 Plug @ 40' with 10 Sks. Cement,
2 Sacks of cement in Rat Hole.

RECEIVED
STATE CORPORATION COMMISSION

OCT 22 1964

CONSERVATION DIVISION
Wichita, Kansas


(If additional description is necessary, use BACK of this sheet)
Name of Plugging Contractor Mayfield-Smith Drlg., Inc.
Address 928 Union Center, Wichita, Kansas

STATE OF Kansas, COUNTY OF Sedgwick, ss.
Charles R. Mayfield

(employee of owner) or (owner or operator) of the above-described well, being first duly sworn on oath, says: That I have knowledge of the facts, statements, and matters herein contained and the log of the above-described well as filed and that the same are true and correct. So help me God.

(Signature) Charles R. Mayfield
Charles R. Mayfield
Wichita, Kansas.
(Address)

Subscribed and sworn to before me this 19th day of October, 19 64

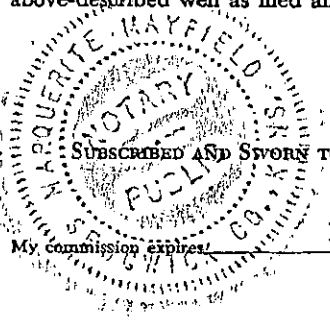

Marguerite Mayfield
Notary Public.

MAYFIELD-SMITH DRILLING, INC.

UNION CENTER BUILDING

OFFICE AM-5389

WICHITA, KANSAS

October 19, 1964

Re: Sam P. Wallingford, Inc. and
Mayfield-Smith Drlg., Inc.
#1 Jenisch SE SW SE 34-16S-12W
Barton County, Kansas

DRILLERS LOG

Date Commenced: October 7, 1964
Date Completed: October 14, 1964
Casing: Set 200' of 8 5/8" W/150 Sx. Cement.

RECEIVED
STATE CORPORATION COMMISSION

OCT 22 1964

CONSERVATION DIVISION
Wichita, Kansas

		TOPS
		Elevation: 1894 K.B.
		(As Per Electric Log)
0 - 140	Clay	Heebner 2981
140 - 200	Blue Shale	Brown Lime 3072
200 - 776	Shale, Sand & Red Bed	Lansing 3091
776 - 800	Anhydrite	Arbuckle 3361
800 - 1576	Shale & Shells	Total Depth 3378
1576 - 2795	Lime & Shale	
2795 - 2872	Lime	
2872 - 2975	Lime & Shale	
2975 - 3378	Lime	

AFFIDAVIT

State of Kansas)
) SS
County of Sedgwick)

I, Charles R. Mayfield, do hereby certify that the above and foregoing is a true and correct Log of the #1 Jenisch, located in the SE SW SE of Section 34, Township 16 South, Range 12 West, Barton County, Kansas, as reflected by the Daily Drilling Reports of Mayfield-Smith Drilling, Inc.

Charles R. Mayfield

Charles R. Mayfield

Subscribed and sworn to before me this 19th day of October, 1964,
a Notary Public in and for Sedgwick County, Kansas.

Marguerite Mayfield

Marguerite Mayfield, Notary Public

My Comm. Expires: 10-26-65

