


15-009-07416-00-01

STATE OF KANSAS  
STATE CORPORATION COMMISSION

Form CP-4

WELL PLUGGING RECORD

Give All Information Completely  
Make Required Affidavit  
Mail or Deliver Report to:  
Conservation Division  
State Corporation Commission  
P. O. Box 17027  
Wichita, Kansas 67217  
NORTH

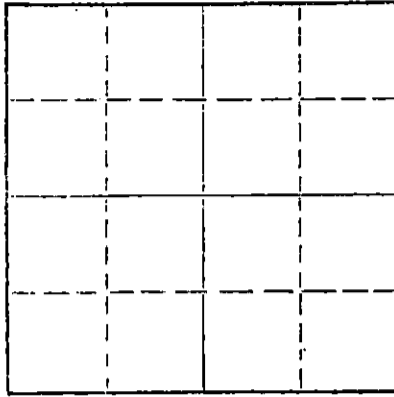

Locate well correctly on above  
Section Plat

Barton County. Sec. 34 Twp. 16 Rge. 12 (E) W (W)  
Location as "NE/CNW/SW" or footage from lines SW/4 SE/4 NE/4  
Lease Owner Shields Oil Producers, Inc.  
Lease Name Jenisch Well No. 4  
Office Address Shields Bldg., Russell Kansas  
Character of Well (completed as Oil, Gas or Dry Hole) Salt water disposal  
Date well completed June 24 19 59  
Application for plugging filed May 13 19 70  
Application for plugging approved May 14 19 70  
Plugging commenced June 10 19 70  
Plugging completed June 10 19 70  
Reason for abandonment of well or producing formation Abandoned lease

If a producing well is abandoned, date of last production \_\_\_\_\_ 19\_\_\_\_  
Was permission obtained from the Conservation Division or its agents before plugging was commenced? Yes

Name of Conservation Agent who supervised plugging of this well Donald Truan  
Producing formation \_\_\_\_\_ Depth to top \_\_\_\_\_ Bottom \_\_\_\_\_ Total Depth of Well 3,392 Feet  
Show depth and thickness of all water, oil and gas formations.

OIL, GAS OR WATER RECORDS

CASING RECORD

FORMATION	CONTENT	FROM	TO	SIZE	PUT IN	PULLED OUT
				8 5/8"	225'	Cmtd.
				4 1/2"	3,356'	Cmtd.

Describe in detail the manner in which the well was plugged, indicating where the mud fluid was placed and the method or methods used in introducing it into the hole. If cement or other plugs were used, state the character of same and depth placed, from \_\_\_\_\_ feet to \_\_\_\_\_ feet for each plug set.

RECEIVED  
STATE CORPORATION COMMISSION  
SEP 6 1972  
CONSERVATION DIVISION  
Wichita, Kansas

Dump 2 sax hulls  
Dump 15 sax cement  
Dump 20 sax mud  
Set bridge plug @200'  
Dump 50 sax cement on plug to cellar

9-6-1972

(If additional description is necessary, use BACK of this sheet)  
Name of Plugging Contractor Shields Oil Producers, Inc.  
Address Shields Bldg., Russell, Kansas

STATE OF KANSAS, COUNTY OF RUSSELL, ss.  
R. J. Shields (owner or operator) of the above-described

well, being first duly sworn on oath, says: That I have knowledge of the facts, statements, and matters herein contained and the log of the above-described well as filed and that the same are true and correct. So help me God.

(Signature) [Signature]  
Shields Bldg., Russell, Kansas  
(Address)

SUBSCRIBED AND SWORN TO before me this 5th day of September, 1972

My commission expires May 26, 1972

[Signature]  
Notary Public.




# Shields

Russell, Kansas

WELL LOG 15-009-07416-00-01

Operator: Shields Oil Producers  
 Well: Jenisch #4  
 Commenced: February 11, 1956  
 Completed: February 22, 1956  
 Contractor: Shields Drilling Co., Inc.

Well Description:  
 S4 SE NE  
 Sec. 34-16-12W  
 Barton County, Kansas

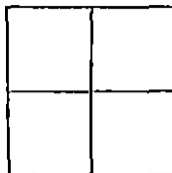

### CASING RECORD

Size	Run	Pulled
8 5/8"	225'	Cmtd. w/125 sax
4 1/2"	3356'	Cmtd. w/100 sax

Elevation: 1905' RB  
 Treatment:

Production:

Tops:

Heebner	2976
Toronto	2993
Douglas	3005
Brown Lime	3069
Lans. - SC	3084
Ch. Cong.	3248
Arbuckle	3353

.....Figures Indicate Bottom of Formations.....

Surface Shells & Lime	40
Shale & Shells	160
Lime stone	225
Shale	360
Sand & Shale	520
Red Bed	825
Red Bed & Shale	1300
Shale & Shells	1110
Shells & Salt	1270
Shale & Shells	1520
Shale & Lime	1950
Lime	2090
Shale & Lime	2260
Shale	2400
Shale Lime Streaks	2545
Lime & Shale	2660
Shale & Lime	2765
Lime	3037
Shale & Lime	3107
Lime	3353
Arbuckle Dol.	3359 RTD

RECEIVED  
 STATE CORPORATION COMMISSION  
 MAY 14 1970  
 CONSERVATION DIVISION  
 Wichita, Kansas

### Notes

DST #1 3075 - 3120 Tool open 1 hr. weak steady blow thru out Sec. 70  
 waxy mud. IFF-0# FFP-0# BHP-900#/20 min.  
 DST #2 3122 - 3155 Tool open 1 hr. Good blow thru out Sec. 335 gas,  
 335' oil cut mud, 120' clean salt water. IFF-30# FFP-230#  
 BHP-930#/20 min.