


Give All Information Completely
Make Required Affidavit
Mail or Deliver Report to:
Conservation Division
State Corporation Commission
211 No. Broadway
Wichita, Kansas

15-009-06366-00-00

WELL PLUGGING RECORD

NORTH

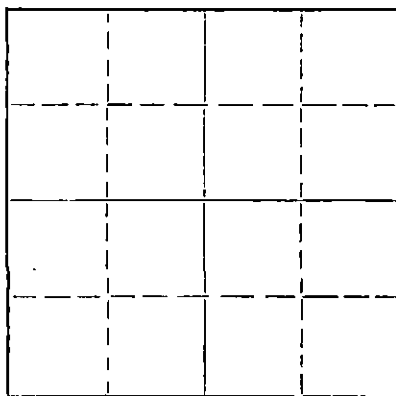

Locate well correctly on above
Section Plat

Barton County. Sec. 35 Twp. 16S Rge. (E) 12 (W)
Location as "NE/CNW/SW" or footage from lines NW SW NW
Lease Owner Petroleum, Inc.
Lease Name KORKISH Well No. 1
Office Address 311 East Third, Wichita, Kansas
Character of Well (completed as Oil, Gas or Dry Hole) Dry Hole
Date well completed April 18 19 56
Application for plugging filed April 18 19 56
Application for plugging approved April 18 19 56
Plugging commenced April 18 19 56
Plugging completed April 18 19 56
Reason for abandonment of well or producing formation Dry Hole

If a producing well is abandoned, date of last production 19
Was permission obtained from the Conservation Division or its agents before plugging was commenced? yes

Name of Conservation Agent who supervised plugging of this well Mr. R. M. Brundage, Hoisington, Kansas
Producing formation _____ Depth to top _____ Bottom _____ Total Depth of Well 3403 Feet
Show depth and thickness of all water, oil and gas formations.

OIL, GAS OR WATER RECORDS

CASING RECORD

FORMATION	CONTENT	FROM	TO	SIZE	PUT IN	PULLED OUT
				8-5/8"	210'	None

Describe in detail the manner in which the well was plugged, indicating where the mud fluid was placed and the method or methods used in introducing it into the hole. If cement or other plugs were used, state the character of same and depth placed, from _____ feet to _____ feet for each plug set.

Mudded up with heavy mud to 205', pushed down

1/3 sack hulls to 205' followed by wooden plug.

Placed 20 sacks cement through drill pipe on top

of plug. Mudded up to 35' and placed 1/3 sack

hulls at 35' followed by wooden plug and 10 sacks

cement to base of well cellar.

(If additional description is necessary, use BACK of this sheet)

Name of Plugging Contractor Garvey Drilling Company
Address R. R. #2 - Great Bend, Kansas

STATE OF KANSAS, COUNTY OF SEDGWICK, ss.
Cullen Thomas (employee of owner) or (~~owner or operator~~) of the above-described well, being first duly sworn on oath, says: That I have knowledge of the facts, statements, and matters herein contained and the log of the above-described well as filed and that the same are true and correct. So help me God.

(Signature) Cullen Thomas

311 East Third, Wichita, Kansas
(Address)

SUBSCRIBED AND SWORN TO before me this 19th day of April, 19 56

My commission expires September 2, 1959

FRANCES SLOAN, Notary Public
My Commission expires Sept. 2, 1959


Notary Public.

RECEIVED
STATE CORPORATION COMMISSION

MAY 1 X 1956

CONSERVATION DIVISION
Wichita, Kansas

5-1-1956

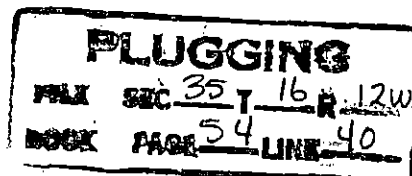

WELL LOG


15-009-06306-00-00

COMPANY **Petroleum, Inc.**

SEC. 35 T. 16S R. 12W

FARM **KORKISH**

NO. 1

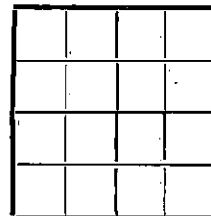LOC. **NW SW 1/4
1650' FSL
130' FSL**TOTAL DEPTH **3403'**COUNTY **Barton**COMM. **April 10, 1956**COMP. **April 18, 1956**CONTRACTOR **Gervey Drilling Company**CASING **8-5/8" @ 210' w/150 cas**ELEVATION **1910' RB**PRODUCTION **D & A**

FIGURES INDICATE BOTTOM OF FORMATIONS

80	Surface Soil & Post Rock
260	Blue Shale
300	Sand
435	Shale
535	Sand & Shale
800	Red Bed
820	Anhydrite
980	Shale
1200	Shale & Shells
1425	Shale & Salt
3168	Lime & Shale
3347	Lime
3389	Lime & Conglomerate
3403	Lime


Sample Tops

Topeka	2785 (- 755)
Keokuk	2992 (-1082)
Toronto	3008 (-1098)
Douglas	3019 (-1109)
Iron Line	3084 (-1174)
Lansing	3099 (-1189)
Cong. Sand	3359 (-1449)
Conglomerate	3384 (-1474)
Arbuckle	3378 (-1468)

RED 3403'

State of **KANSAS**County of **SEDGWICK**I, **Cullen Thomas**

of

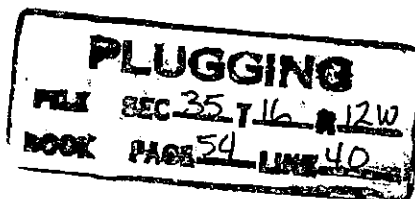Petroleum, Inc.upon oath state that the above and foregoing is a true and correct copy of the log of the **KORKISH #1** wellSubscribed and sworn to before me this **26th** day of **April** 19 **56**My Commission Expires: **September 2, 1959**

MAY 1 1956

NOTARY PUBLIC

REGISTRATION DIVISION
Wichita, KansasFRANCES SLOAN, Notary Public
My Commission expires Sept. 2, 1959