


STATE OF KANSAS  
STATE CORPORATION COMMISSION

Give All Information Completely  
Make Required Affidavit  
Mail or Deliver Report to:  
Conservation Division  
State Corporation Commission  
800 Bittig Building  
Wichita, Kansas

15-009-06307-00-00  
WELL PLUGGING RECORD

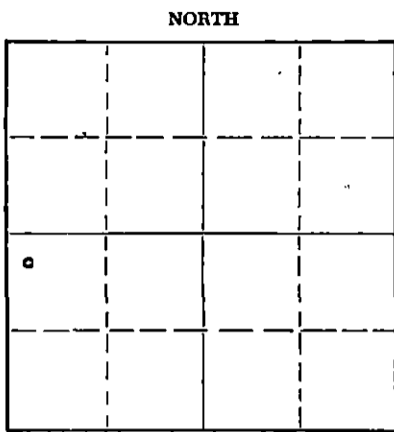

Locate well correctly on above Section Plat

Barton County. Sec. 35 Twp. 16 Rge. 12 (E) W (W)  
Location as "NE/CNW/SW" or footage from lines NW/4 NW/4 SW/4  
Lease Owner Shields Oil Producers  
Lease Name Korkisch "A" Well No. 1  
Office Address Box 248, Russell, Kansas  
Character of Well (completed as Oil, Gas or Dry Hole) Dry Hole  
Date well completed October 10, 1955 19 55  
Application for plugging filed 6:30 A. M. October 10 19 55  
Application for plugging approved 6:30 A. M. October 10 19 55  
Plugging commenced 9:30 A. M. October 10 19 55  
Plugging completed 12:00 Noon October 10 19 55  
Reason for abandonment of well or producing formation Dry Hole

If a producing well is abandoned, date of last production \_\_\_\_\_ 19 \_\_\_\_\_  
Was permission obtained from the Conservation Division or its agents before plugging was commenced? Yes

Name of Conservation Agent who supervised plugging of this well W. H. Horner  
Producing formation \_\_\_\_\_ Depth to top \_\_\_\_\_ Bottom \_\_\_\_\_ Total Depth of Well \_\_\_\_\_ Feet  
Show depth and thickness of all water, oil and gas formations.

OIL, GAS OR WATER RECORDS

CASING RECORD

FORMATION	CONTENT	FROM	TO	SIZE	PUT IN	PULLED OUT
				8 5/8"	202'	Cmtd w/150 Sax

Describe in detail the manner in which the well was plugged, indicating where the mud fluid was placed and the method or methods used in introducing it into the hole. If cement or other plugs were used, state the character of same and depth placed, from \_\_\_\_\_ feet to \_\_\_\_\_ feet for each plug set.

Heavy Mud to 200'  
Set bridging plug @200', 1/2 sax hulls on plug, 20 sax cement thru 4 1/2" drill pipe on plug  
Heavy Mud to 35'  
Set bridging plug @35', 1/2 sax hulls on plug, 5 sax cement to surface.

RECEIVED  
STATE CORPORATION COMMISSION  
OCT 21 1955  
CONSERVATION DIVISION  
Wichita, Kansas

(If additional description is necessary, use BACK of this sheet)  
Name of Plugging Contractor Shields Drilling Co., Inc.  
Address Box 248 - Russell, Kansas

10-21-1955

STATE OF Kansas, COUNTY OF Russell, ss.  
R. J. Shields (employee of owner) or (owner or operator) of the above-described well, being first duly sworn on oath, says: That I have knowledge of the facts, statements, and matters herein contained and the log of the above-described well as filed and that the same are true and correct. So help me God.

(Signature) R. J. Shields  
Box 248, Russell, Kansas  
(Address)

SUBSCRIBED AND SWORN TO before me this 14th day of October, 19 55

My commission expires 12-18-1957

Jack P. Beeman  
Notary Public.

PLUGGING  
FILED SEC-35 T-16 R-12W  
BOOK PAGE 9 LINE 43




# Shields

Russell, Kansas

WELL LOG 15-009-06307-00-00

Operator: Shields Oil Producers  
 Well: Korkisch "A" #1  
 Commenced: September 29, 1955  
 Completed: October 10, 1955  
 Contractor: Shields Drilling Co., Inc.

Well Description: NW NW SW

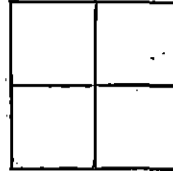

Sec. 35-16-12W  
 Barton County, Kansas

### CASING RECORD

Size	Run	Pulled
8 5/8"	202'	Cmtd. with 150 sax

Elevation: 1905' RB

Treatment: None

Production: D&A

Tops:	Heebner	2988'
	Brown Lime	3079'
	Lans. K. C.	3095'
	Cong. Sand	3363'
	Cherty Cong.	3366'

.....Figures Indicate Bottom of Formations.....

Surface Limestone	60
Shale	80
Sand	115
Shale	355
Sand & Shale	525
Red Bed	550
Red Bed & Shale	789
Anhydrite	815
Red Bed Shale & Shells	1155
Salt & Shale Streaks	1350
Shale	1515
Shale & Lime	1630
Lime & Shale	2290
Shale & Lime	2690
Lime & Shale	2820
Lime	2895
Lime & Shale	2958
Lime	3075
Lime & Shale	3115
Lime	3390 TD

DST #1-2995-3115. Tool open 1 hr. Weak blow for 55 minutes. Recovered 62' rotary mud BHP-930#/20 min.

DST #2-3118-3167. Tool open 1 hr. Good blow throughout. Recovered 1040' salt water. IFP-160#, FFP-580#, BHOP-960#/20 minutes.

RECEIVED  
OIL CORPORATION COMMISSION

OCT 21 1955

PRESERVATION DIVISION  
Wichita, Kansas

Notes

**PLUGGING**  
 FILE SEC 35 T 16 R 12 W  
 BOOK PAGE 9 LINE 43