

WELL PLUGGING RECORD

FORMATION PLUGGING RECORD

**Strike out upper line
when reporting plug-
ging off formations.**

NORTH

A 4x4 grid with a dot at (1, 3) and the number 36 at (2, 2).

Locate well correctly on above
Section Plat

State Corporation Commission
800 Bittling Building
Wichita, Kansas

Barton County. Sec. 36 Twp. 16 Rge. (E) 12 (W)

Location as "NE $\frac{1}{4}$ NW $\frac{1}{4}$ SW $\frac{1}{4}$ " or footage from lines. NE NE NW

Lease Owner. Sterling Drilling Company

Lease Name. Seyfert Well No. 1

Office Address. Sterling, Ks.

Character of Well (completed as Oil, Gas or Dry Hole) Dry Hole

Date well completed. July 22nd, 1946

Application for plugging filed. 19

Application for plugging approved. 19

Plugging commenced. July 22nd, 1946

Plugging completed. July 22nd, 1946

Reason for abandonment of well or producing formation. Dry Hole

If a producing well is abandoned, date of last production. 19

Was permission obtained from the Conservation Division or its agents before plugging was commenced? yes

Name of Conservation Agent who supervised plugging of this well. H. W. Kerr

Producing formation. Depth to top. Bottom. Total Depth of Well. 3433 Feet

Show depth and thickness of all water, oil and gas formations.

NORTH

	•		
	36		

Locate well correctly on above Section Plat

CASTING RECORD

[illegible]

Describe in detail the manner in which the well was plugged, indicating where the mud fluid was placed and the method or methods used in introducing it into the hold. If cement or other plugs were used, state the character of same and depth placed, from.....feet tofeet for each plug set.

Filled with heavy mud to 240 feet, set bridge and cemented with 15 sacks of cement. Filled with heavy mud to within fifteen feet of bottom of cellar, set bridge and cemented with ten sacks of cement.

(If additional description is necessary, use BACK of this sheet)

Correspondence regarding this well should be addressed to.....Sterling Drilling Co.
Address.....Sterling, Kansas

STATE OF Kansas, COUNTY OF Rice, ss.
Rollin Mead, (employee of owner) or (owner or operator) of the above-described well,
 being first duly sworn on oath, says: That I have knowledge of the facts, statements, and matters herein contained and the log of the above-described well as filed and that the same are true and correct. So help me God.

(Signature)

Sterling, Ks.
(Address)

SUBSCRIBED AND SWORN to before me this 21st day of August, 1946

My commission expires, Sept. 17th, 1949.

Notary Public.

STERLING DRILLING COMPANY
STERLING, KANSAS

WELL LOG * * - - - - - STERLING DRILLING COMPANY

Seyfert #1

Location NE/4 NE/4 NW/4 Section 36, T 16, R 12, Barton County, Kansas

Elevation 1935

Date Commenced July 10, 1946

Completed July 22, 1946

Rotary tools 0 to 3433

Casing record

280 feet 10" surface pipe

cemented 140 sacks cement

Plugged and abandoned

Log


0-286 Shale & Shells
 286-560 Shale & Shells
 560-795 Sandy Shale
 795-835 Anhydrite
 835-1200 Red bed-Shale & Shells
 1200-1500 Shale & Salt
 1500-1575 Shale & Shells
 1575-1640 Lime
 1640-2160 Shale & Lime
 2160-2305 Shale & Shells
 2305-2450 Shale & Lime
 2450-2705 Shale & Shells
 2705-2755 Lime & Shale
 2755-2995 Lime
 2995-3105 Shale
 3105-3305 Lime
 3305-3379 Lime & Conglomerate
 3379-3385 Sand
 3385-3404 Lime
 3404-3433 Arbuckle
 3433 T D

Formation tops

Anhydrite 795 feet
 Topeka 2750 "
 Lansing 3116 "
 Conglomerate 3365 feet
 Arbuckle 3404

Production

None - Dry

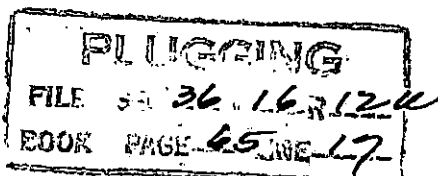

The above is a true and correct copy of drilling log on
 Seyfert No. 1 NE/4 NE/4 NW/4 Section 36, T16, R 12, Barton County, Kansas

Sterling Drilling Company

BY: H. C. Sullivan
President

1946.

Subscribed and sworn to before me this 25th day of July,

J. A. Weller
 Notary Public

My term expires September 17, 1949