

STATE OF KANSAS
STATE CORPORATION COMMISSION

15-009-06010-00-00


WELL PLUGGING RECORD

Give All Information Completely
Make Required Affidavit
Mail or Deliver Report to:
Conservation Division
State Corporation Commission
211 No. Broadway
Wichita, Kansas

Barton County, Sec. 36 Twp. 16 Rge. 12 (E) (W)

Location as "NE/CNW/SW" or footage from lines NE NW NE
Lease Owner Neil Dunlavy
Lease Name Hoffman Well No. 1
Office Address P. O. Box 288 North Platte, Nebraska
Character of Well (completed as Oil, Gas or Dry Hole) dry hole
Date well completed March 12 19 59
Application for plugging filed March 12 19 59
Application for plugging approved March 12 19 59
Plugging commenced March 12 19 59
Plugging completed March 12 19 59
Reason for abandonment of well or producing formation dry hole

NORTH

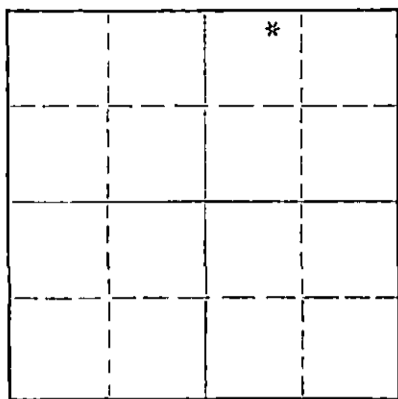

Locate well correctly on above Section Plat

If a producing well is abandoned, date of last production _____ 19____
Was permission obtained from the Conservation Division or its agents before plugging was commenced? Yes

Name of Conservation Agent who supervised plugging of this well Don Truan
Producing formation _____ Depth to top _____ Bottom _____ Total Depth of Well 3400 Feet
Show depth and thickness of all water, oil and gas formations.


OIL, GAS OR WATER RECORDS

CASING RECORD

FORMATION	CONTENT	FROM	TO	SIZE	PUT IN	PULLED OUT
Surface Pipe		-0-	280'	8 5/8"	280'	-0-

Describe in detail the manner in which the well was plugged, indicating where the mud fluid was placed and the method or methods used in introducing it into the hole. If cement or other plugs were used, state the character of same and depth placed, from _____ feet to _____ feet for each plug set.

Filled hole with heavy mud.
Set plug at 270'.
Mixed and dumped 25 sacks cement with 1/3 sack hulls.
Set top plug at 40'.
Mixed and dumped 10 sacks cement with 1/2 sack hulls to top of surface.

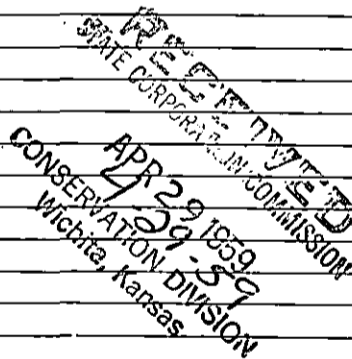

(If additional description is necessary, use BACK of this sheet)

Name of Plugging Contractor A. L. Jackson Drilling Company
Address Box 194 Great Bend, Kansas

STATE OF Kansas, COUNTY OF Barton, ss.
C. L. Miles, partner of Contractor (employee of owner) or (owner or operator) of the above-described well, being first duly sworn on oath, says: That I have knowledge of the facts, statements, and matters herein contained and the log of the above-described well as filed and that the same are true and correct. So help me God.

(Signature) C. L. Miles
Box 194 Great Bend, Kansas
(Address)

SUBSCRIBED AND SWORN TO before me this 13th day of March, 19 59

Dick B. Evans

Dick B. Evans Notary Public.

My commission expires May 9, 1959

PLUGGING
FILE SEC. 36 T. 16 R. 12w
BOOK PAGE 24 LINE 29

15-009-06010-00-00

W E L L L O G
Hoffman # 1
NE NW NE 36-16-12
Barton County, Kansas

0 - 40	Top soil and clay	Elevation	1924' KB
40 - 120	Shale		
120 - 160	Sand		
160 - 280	Shale and shells		
280 - 500	Shale	<u>Formation Tops:</u>	
500 - 778	Red bed	Anhydrite	778'
778 - 807	Anhydrite	Heebner	2985'
807 - 1325	Shale and shells	Toronto	3003'
1325 - 1520	Shale	Douglas	3015'
1520 - 1620	Lime and shale	B. Lime	3084'
1620 - 1905	Lime	Kansas City	3102'
1905 - 2170	Lime and shale	Arbuckle	3354'
2170 - 2290	Shale and shells		
2290 - 2420	Shale		
2420 - 2570	Shale and lime		
2570 - 2790	Shale		
2790 - 2895	Lime		
2895 - 2955	Lime and shale		
2955 - 3332	Lime		
3332 - 3355	Lime and shale		
3355 - 3400	Lime		
3400	T. D.		

STATE OF KANSAS
APR 29 1959
WICHITA

STATE OF KANSAS
COUNTY OF BARTON ss

C. L. Miles, partner of A. L. Jackson Drilling Company, being first duly sworn on oath says: That I have knowledge of the facts, statements and matters herein contained and the log of the above described well as filed and that the same are true and correct.

C. L. Miles
C. L. Miles

Subscribed and sworn before me this 13th day of March, 1959.

Notary Public Barton County

My Commission Expires: May 9, 1959

PLUGGING
FILE SEC. 36 T. 16 R. 12W
BOOK PAGE 29 LINE 29