


WELL PLUGGING RECORD

Give All Information Completely
Make Required Affidavit
Mail or Deliver Report to:
Conservation Division
State Corporation Commission
800 Bitting Building
Wichita, Kansas

Stafford County. Sec. 3 Twp. 21 Rge. 11 (E) (W)
Location as "NE/CNW/SW" or footage from lines NE NW NW
Lease Owner Darrah & Garvin
Lease Name DAVIS Well No. 2
Office Address 303 South Main, Wichita, Kansas.
Character of Well (completed as Oil, Gas or Dry Hole) Dry Hole
Date well completed January 15, 19 54
Application for plugging filed January 15, 19 54
Application for plugging approved January 15, 19 54
Plugging commenced January 15, 19 54
Plugging completed January 15, 19 54
Reason for abandonment of well or producing formation Dry Hole

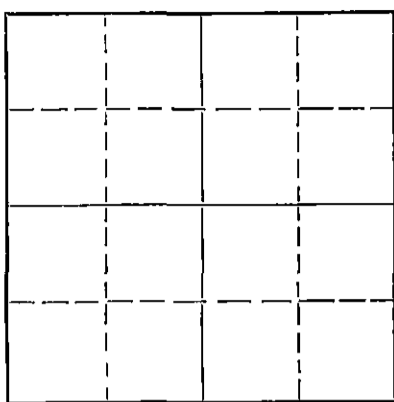

Locate well correctly on above Section Plat

If a producing well is abandoned, date of last production 19
Was permission obtained from the Conservation Division or its agents before plugging was commenced? Yes

Name of Conservation Agent who supervised plugging of this well Mr. M. A. Rives
Producing formation _____ Depth to top _____ Bottom _____ Total Depth of Well 2610 Feet
Show depth and thickness of all water, oil and gas formations.

OIL, GAS OR WATER RECORDS

CASING RECORD

FORMATION	CONTENT	FROM	TO	SIZE	PUT IN	PULLED OUT
				8-5/8"	812'	None

Describe in detail the manner in which the well was plugged, indicating where the mud fluid was placed and the method or methods used in introducing it into the hole. If cement or other plugs were used, state the character of same and depth placed, from _____ feet to _____ feet for each plug set.

Mudded up to 270'. Set wooden plug at 270' with 1 1/2 gal. bulls ahead of plug. Displaced 20 sacks cement through drill pipe onto plug at 270'. Mudded up to 40' and set wooden plug. Filled hole to bottom of cellar with 10 sacks cement.

RECEIVED
STATE CORPORATION COMMISSION

JAN 23 1954

CONSERVATION DIVISION
Wichita, Kansas

(If additional description is necessary, use BACK of this sheet)
Name of Plugging Contractor Garvey Drilling Contractor
Address R.R. #2, Great Bend, Kansas.

1-20-1954


STATE OF KANSAS, COUNTY OF SEDGWICK
W. W. Fisher (Agent of owner) of the above-described well, being first duly sworn on oath, says: That I have knowledge of the facts, statements, and matters herein contained and the log of the above-described well as filed and that the same are true and correct. So help me God.

(Signature) W. W. Fisher
305 East 3rd, Wichita, Kansas.
(Address)

SUBSCRIBED AND SWORN TO before me this 18th day of January, 19 54

My commission expires October 13, 1954.

Notary Public.

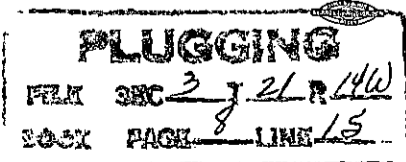

DRILLER'S LOG DAVIS #2

John Jay Darrah, Operator

Section 3, Twp. 21S, Rge. 11W

Garvey Drilling Company, Contractor

Location: NE NW NW

Drilling Commenced: January 5, 1954.

County: Stafford County, Kansas.

Drilling Completed: January 15, 1954.

Production: D & A

Casing Record: 8-5/8" @ 812' w/400 sax.

Figures below indicate bottom of formation:

- 70 Sand
- 240 Shale & Sand
- 260 Shale
- 335 Sand
- 805 Shale & Red Bed
- 840 Anhydrite
- 1415 Red Bed & Shale
- 1700 Shale & Lime
- 1925 Lime
- 2530 Lime & Shale
- 2850 Shale & Shells
- 3040 Lime & Shale
- 3240 Lime
- 3300 Lime & Shale
- 3524 Lime
- 3575 Shale, Sand, & Lime
- 3598 Lime & Shale
- 3610 Lime

- 3610 R.T.D.

RECEIVED
 JAN 21 1954
 CONSERVATION DIVISION
 Wichita, Kansas

I hereby certify that this is a true and correct log of the above mentioned well.

GARVEY DRILLING COMPANY

By W W Lusk

STATE OF KANSAS)
) SS:
 COUNTY OF SEDGWICK)

Subscribed to and sworn to before me, a Notary Public, in said County and State, this 19th day January, 1954.

PLUGGING
 FILE REC 3 T 21 R 14W
 BOOK PAGE 8 LINE 15

Charlow Meadman
 Notary Public

My commission expires: October 13, 1954.