


STATE OF KANSAS  
STATE CORPORATION COMMISSION

WELL PLUGGING RECORD

Give All Information Completely  
Make Required Affidavit  
Mail or Deliver Report to  
Conservation Division  
State Corporation Comm.  
245 North Water  
Wichita, KS 67202

Stafford County, Sec. 3 Twp. 21S Rge. 14W E&W  
Location as "NE/CNW $\frac{1}{4}$ SW $\frac{1}{4}$ " or footage from lines  
NW NE NE

Lease Owner Alpine Drilling Co., Inc.  
Lease Name Nina Davis Well No. B-1  
Office Address 800 Bitting Bldg., Wichita, KS 67202  
Character of Well (Completed as Oil, Gas or Dry Hole)  
Dry Hole

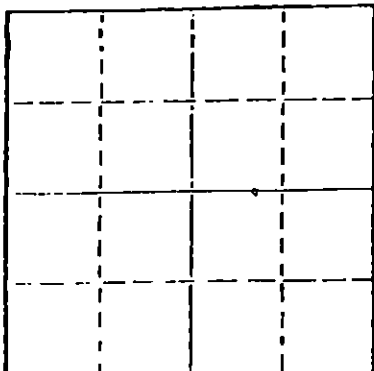

Locate well correctly on above  
Section Plat

Date Well completed October 17 1979  
Application for plugging filed October 17 1979  
Application for plugging approved October 17 1979  
Plugging commenced October 17 1979  
Plugging completed October 17 1979  
Reason for abandonment of well or producing formation

If a producing well is abandoned, date of last production 19

Was permission obtained from the Conservation Division or  
its agents before plugging was commenced? yes

Name of Conservation Agent who supervised plugging of this well Duane Rankin, Great Bend, KS  
Producing formation Depth to top Bottom Total Depth of Well 3662  
Show depth and thickness of all water, oil and gas formations.

OIL, GAS OR WATER RECORDS

CASING RECORD

FORMATION	CONTENT	FROM	TO	SIZE	PUT IN	PULLED OUT

Describe in detail the manner in which the well was plugged, indicating where the mud fluid was placed and the method or methods used in introducing it into the hold. If cement or other plugs were used, state the character of same and depth placed, from feet to feet for each plug set.

Plugged as follows:

Filled hole w/mud, pumped 50 sx 50/50 pozmix w/4% gel thru open end D.P. @ 450'; mud to 330'; pumped 25 sx thru open end D.P., mud to 40'; 1/2 sx hulls & wood bridge; pumped 10 sx to base of cellar; 5 sx in rathole complete at 2:30 p.m. 10-17-79

Witnessed: Duane Rankin, State Pluggger, Great Bend, Kansas  
Gary Bagby, Sterling, KS

(If additional description is necessary, use BACK of this sheet)

Name of Plugging Contractor Husky Drilling Co., Inc.

STATE OF Kansas COUNTY OF Sedgwick, ss.  
Jon T. Williams, Jr. (employee of owner) or (owner or operator)  
of the above-described well, being first duly sworn on oath, says: That I have knowledge of the facts, statements, and matters herein contained and the log of the above-described well as filed and that the same are true and correct. So help me God.


(Signature)

800 Bitting Bldg., Wichita, KS 67202  
(Address)

SUBSCRIBED AND SWORN TO before me this 19th day of October, 19 79

Geraldine Stewart  
Geraldine Stewart Notary Public.

My commission expires January 12, 1981

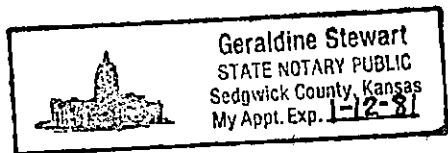

RECEIVED  
STATE CORPORATION COMMISSION

OCT 22 1979

CONSERVATION DIVISION  
Wichita, Kansas

10-22-1979

