


WELL PLUGGING RECORD

Give All Information Completely
Make Required Affidavit
Mail or Deliver Report to:
Conservation Division
State Corporation Commission
211 No. Broadway
Wichita, Kansas

Stafford County, Sec. 3 Twp. 21 Rge. 14 (E)X (W)
Location as "NE/CNW/SW" or footage from lines. S 1/4 S 1/4 SE
Lease Owner G.M.W., Inc.
Lease Name Davis Well No. 1
Office Address Box 510, El Dorado, Kansas
Character of Well (completed as Oil, Gas or Dry Hole) oil well
Date well completed 19____
Application for plugging filed 8-9-65 19____
Application for plugging approved 8-11-65 19____
Plugging commenced 8-23-65 19____
Plugging completed 8-27-65 19____
Reason for abandonment of well or producing formation depleted

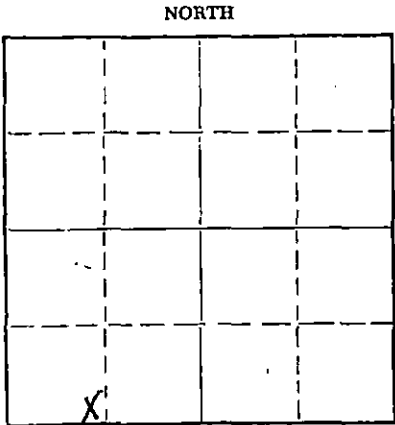

Locate well correctly on above
Section Plat

If a producing well is abandoned, date of last production 19____
Was permission obtained from the Conservation Division or its agents before plugging was commenced? yes

Name of Conservation Agent who supervised plugging of this well Archie Flying
Producing formation _____ Depth to top _____ Bottom _____ Total Depth of Well 3585 Feet
Show depth and thickness of all water, oil and gas formations.

OIL, GAS OR WATER RECORDS

CASING RECORD

FORMATION	CONTENT	FROM	TO	SIZE	PUT IN	PULLED OUT
				8 5/8	375	none
				5 1/2	3585	2226.57

Describe in detail the manner in which the well was plugged, indicating where the mud fluid was placed and the method or methods used in introducing it into the hole. If cement or other plugs were used, state the character of same and depth placed, from _____ feet to _____ feet for each plug set.

Set 15' rock bridge from 3450' to 3435' and dump 5 sacks cement.
Globe Cementing Co. pumped 80' sacks cement and 10 sacks jell
down surface pipe w/250 lbs pressure

RECEIVED
STATE CORPORATION COMMISSION

SEP 7 1965

CONSERVATION DIVISION
Wichita, Kansas

(If additional description is necessary, use BACK of this sheet)

Name of Plugging Contractor Flint Engineering & Construction Company
Address Box 950, El Dorado, Kansas

STATE OF KANSAS, COUNTY OF BUTLER, ss.

_____(employee of owner) or (owner or operator) of the above-described well, being first duly sworn on oath, says: That I have knowledge of the facts, statements, and matters herein contained and the log of the above-described well as filed and that the same are true and correct. So help me God.

(Signature) Charles Bowdle
El Dorado, Kansas
(Address)

SUBSCRIBED AND SWORN to before me this 2nd day of September 19 65

My commission expires

9-27-67

Ronald R. Hanson
Notary Public.