


STATE OF KANSAS  
STATE CORPORATION COMMISSION

Give All Information Completely  
Make Required Affidavit  
Mail or Deliver Report to:  
Conservation Division  
State Corporation Commission  
212 No. Market  
Wichita, Kansas

WELL PLUGGING RECORD

Stafford County. Sec. 1 Twp. 21 Rge. (E) 14 (W)  
Location as "NE/CNW/SW" or footage from lines. NWc  
Lease Owner Tomlinson Oil Company  
Lease Name Morrison Well No. 1  
Office Address 1125 Wichita Plaza Bldg.  
Character of Well (completed as Oil, Gas or Dry Hole) Dry Hole  
Date well completed April 29 1969  
Application for plugging filed April 29 1969  
Application for plugging approved April 29 1969  
Plugging commenced April 29 1969  
Plugging completed April 29 1969  
Reason for abandonment of well or producing formation Dry

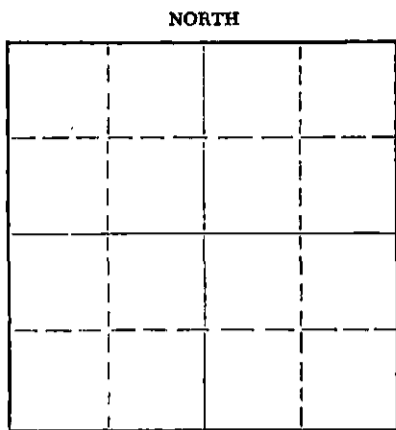

Locate well correctly on above Section Flat

If a producing well is abandoned, date of last production 19  
Was permission obtained from the Conservation Division or its agents before plugging was commenced? Yes

Name of Conservation Agent who supervised plugging of this well Ralph J. Warren  
Producing formation \_\_\_\_\_ Depth to top \_\_\_\_\_ Bottom \_\_\_\_\_ Total Depth of Well 3700 Feet  
Show depth and thickness of all water, oil and gas formations.

OIL, GAS OR WATER RECORDS

CASING RECORD

FORMATION	CONTENT	FROM	TO	SIZE	PUT IN	REMOVED OUT
				8 5/8	238	

RECEIVED  
STATE CORPORATION COMMISSION  
MAY 2 1969  
CONSERVATION DIVISION  
Wichita, Kansas

Describe in detail the manner in which the well was plugged, indicating where the mud fluid was placed and the method or methods used in introducing it into the hole. If cement or other plugs were used, state the character of same and depth placed, from \_\_\_\_\_ feet to \_\_\_\_\_ feet for each plug set.

Bottom plug @ 450' w/50 sx.  
Middle plug @ 230' w/25 sx.  
Top plug @ 40' w/10 sx.

(If additional description is necessary, use BACK of this sheet)

Name of Plugging Contractor Woodman & Iannitti Drilling Company  
Address 706 Union National Building

STATE OF KANSAS, COUNTY OF SEDGWICK, ss.  
K. T. WOODMAN (employee of owner) or (operator) of the above-described well, being first duly sworn on oath, says: That I have knowledge of the facts, statements, and matters herein contained and the log of the above-described well as filed and that the same are true and correct. So help me God.

(Signature) K. T. Woodman

706 Union National Bldg.  
(Address)

SUBSCRIBED AND SWORN TO before me this 2nd day of May, 1969

My commission expires Feb. 11, 1972

Justina Chamberlain  
Justina Chamberlain Notary Public.

KANSAS GEOLOGICAL SOCIETY  
 KANSAS WELL LOG BUREAU - KANSAS WELL SAMPLE BUREAU  
 KANSAS GEOLOGICAL SOCIETY BUILDING  
 508 EAST MURDOCK - WICHITA, KANSAS

15.185.20169.0000

COMPANY Stafford

SEC. 1 T. 21 R. 14W

FARM Morrison

NO. 1

LOC. NWC

COUNTY Stafford

TOTAL DEPTH 3700


COMM. April 22, 1969

COMP. April 29, 1969

SHOT OR TREATED

CONTRACTOR Woodman & Iannitti Drilling Co.

ISSUED

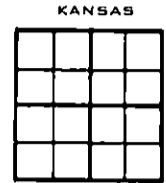

CASING

20	10	
15	8	236' w/250 sx
12	6	
13	5	

ELEVATION

PRODUCTION D & A

FIGURES INDICATE BOTTOM OF FORMATIONS

210	Sand
240	Shale
315	Sand
320	Sand & Red Bed
810	Red Bed & Streaks of Sand
845	Anhy
1456	Red Bed & Shale
1600	Lime
1835	Lime & Shale
2045	Lime
2225	Lime
2520	Shale & Lime
2775	Lime & Shale
2915	Lime
3060	Lime
3142	Lime
3230	Lime
3345	Lime & Shale
3382	Lime
3465	Lime
3525	Lime
3565	Lime
3570	Lime
3613	Lime & Chert
3650	Lime
3700	Arb.

**RECEIVED**  
 STATE CORPORATION COMMISSION  
 MAY 2 1969  
 CONSERVATION DIVISION  
 Wichita, Kansas

I certify the above to be a true and correct copy of the driller's log and the geological tops to the best of my knowledge and belief.

Woodman & Iannitti Drilling Company

*K. T. Woodman*  
 K. T. Woodman