

WELL PLUGGING RECORD

Give All Information Completely
Make Required Affidavit
Mail or Deliver Report to:
Conservation Division
State Corporation Commission
211 No. Broadway
Wichita, Kansas

Stafford

County, Sec. 1 Twp. 21S Rge. 14W(E) (W)

Location as "NE/CNW/SW" or footage from lines SW SE SE

Lease Owner ALPINE OIL & ROYALTY CO., INC.

Lease Name Morrison "B" Well No. 3

Office Address 800 Bitting Building, Wichita, Kansas

Character of Well (completed as Oil, Gas or Dry Hole) dry hole

Date well completed February 13, 1964 19

Application for plugging filed February 13, 1964 19

Application for plugging approved February 13, 1964 19


Plugging commenced February 13, 1964 19

Plugging completed February 13, 1964 at 5:30 P. M. 19

Reason for abandonment of well or producing formation non-productive in commercial quantities

If a producing well is abandoned, date of last production 19

Was permission obtained from the Conservation Division or its agents before plugging was commenced? yes

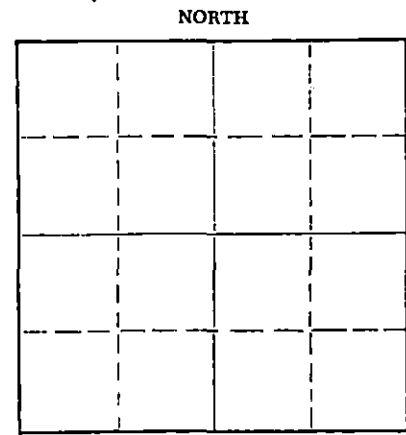

Locate well correctly on above Section Plat

Name of Conservation Agent who supervised plugging of this well Archie V. Elving

Producing formation Depth to top Bottom Total Depth of Well 3642 Feet

Show depth and thickness of all water, oil and gas formations.

OIL, GAS OR WATER RECORDS

CASING RECORD

FORMATION	CONTENT	FROM	TO	SIZE	PUT IN	PULLED OUT
				8 5/8"	282'	Cemented

Describe in detail the manner in which the well was plugged, indicating where the mud fluid was placed and the method or methods used in introducing it into the hole. If cement or other plugs were used, state the character of same and depth placed, from feet to feet for each plug set.

Heavy mud from Total Depth 3642 feet to 275 feet - solid plug and 25 sacks cement through ~~drill~~ drill pipe, mud to 40 feet - solid plug and 10 sacks cement - 2 sacks in rat hole

RECEIVED
STATE CORPORATION COMMISSION

FEB 28 1964

CONSERVATION DIVISION
Wichita, Kansas

(If additional description is necessary, use BACK of this sheet)

Name of Plugging Contractor Quaker Drilling Co., Inc.

Address 800 Bitting Building, Wichita, Kansas

STATE OF Kansas, COUNTY OF Sedgwick, ss.

Thomas M. McCaul

(employee of owner) or (owner or operator) of the above-described well, being first duly sworn on oath, says: That I have knowledge of the facts, statements, and matters herein contained and the log of the above-described well as filed and that the same are true and correct. So help me God.

(Signature)

Thomas M. McCaul

800 Bitting Building, Wichita, Kansas

(Address)

SUBSCRIBED AND SWORN TO before me this 17th day of February, 1964

My commission expires August 10, 1965

[Signature]
Notary Public.

WELL LOG

ALPINE OIL & ROYALTY CO., INC.

Commenced: February 4, 1964

Contractor: Quaker Drilling Co., Inc.

Completed: February 13, 1964

In Re: Morrison No. 3-B
 SW SE SE Sec. 1-21S-14W
 Stafford County, Kansas

Production: D. & A.

Elevation: 1916 K. B.

Casing Record

Set 8 5/8 inch casing at 282 feet with 275 sacks cement

(Figures Indicate the Bottom of the Formations)


<u>FORMATION</u>	<u>DEPTH</u>	<u>FORMATION TOPS</u>	
Soil and Clay	30	Heebner	3209 -1293
Sand and Gravel	240	Brown Lime	3325 -1409
Shale	285	Lansing	3335 -1419
Sand	365	Base of Kansas City	3555 -1639
Red Bed	807	Viola	3561 -1645
Anhydrite	835	Simpson	3582 -1666
Shale and Shells	1550	Arbuckle	3636 -1720
Lime and Shale	3410	Rotary Total Depth	3642 -1726
Lime	3545		
Cherty Lime and Shale	3536		
Dolomite	3642		

We hereby certify the foregoing to be a true and correct copy of the test drilled in the SW SE SE of Section 1, Township 21 South, Range 14 West, Stafford County, Kansas.

QUAKER DRILLING CO., INC.

By: 
 Thomas M. McCaul

SUBSCRIBED AND SWORN TO BEFORE ME a Notary Public this 17th day of February, 1964.

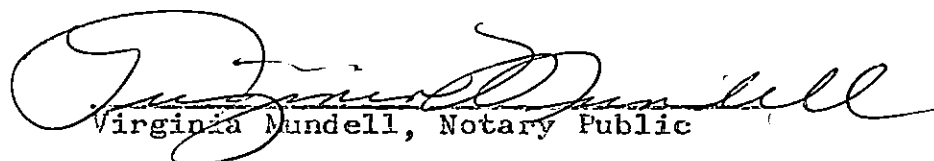
 Virginia Mundell, Notary Public

MY COMMISSION EXPIRES:
 August 10, 1965

RECEIVED
 STATE CORPORATION COMMISSION

FEB 28 1964

CONSERVATION DIVISION
 Wichita, Kansas