


WELL PLUGGING RECORD

Give All Information Completely  
Make Required Affidavit  
Mail or Deliver Report to:  
Conservation Division  
State Corporation Commission  
212 North Market, Insurance Bldg.  
Wichita, Kansas

Stafford County, Sec. 1 Twp. 21S Rge. 14W (E) (W)  
Location as "NE/CNW/SW" or footage from lines NW SW SE  
Lease Owner ALPINE OIL & ROYALTY CO., INC.  
Lease Name WAYNE L. MORRISON Well No. 1 "B"  
Office Address 800 Bitting Building, Wichita, Kansas  
Character of Well (completed as Oil, Gas or Dry Hole) Dry Hole  
Date well completed May 17, 1959 19\_\_\_\_  
Application for plugging filed May 17, 1959 19\_\_\_\_  
Application for plugging approved May 17, 1959 19\_\_\_\_  
Plugging commenced May 17, 1959 19\_\_\_\_  
Plugging completed May 17, 1959 19\_\_\_\_  
Reason for abandonment of well or producing formation Non-productive in commercial quantities  
If a producing well is abandoned, date of last production \_\_\_\_\_ 19\_\_\_\_  
Was permission obtained from the Conservation Division or its agents before plugging was commenced? Yes

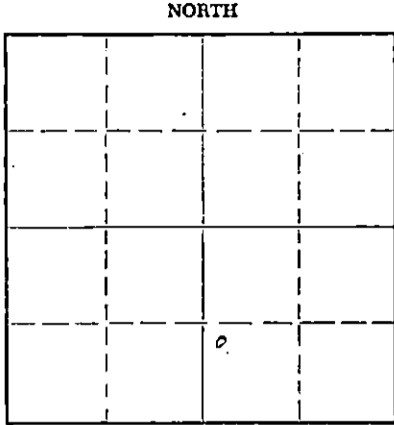

Locate well correctly on above Section Plat

Name of Conservation Agent who supervised plugging of this well Frank Broadfoot  
Producing formation \_\_\_\_\_ Depth to top \_\_\_\_\_ Bottom \_\_\_\_\_ Total Depth of Well 3700 Feet  
Show depth and thickness of all water, oil and gas formations.

OIL, GAS OR WATER RECORDS

CASING RECORD

FORMATION	CONTENT	FROM	TO	SIZE	PUT IN	PULLED OUT
				8 5/8"	280'	cemented

Describe in detail the manner in which the well was plugged, indicating where the mud fluid was placed and the method or methods used in introducing it into the hole. If cement or other plugs were used, state the character of same and depth placed, from \_\_\_\_\_ feet to \_\_\_\_\_ feet for each plug set.

Heavy mud from Total Depth 3700 feet to Surface  
Welded collar on Surface Casing and Halliburton  
pumped 80 sacks cement in to plug hole.

RECEIVED  
STATE CORPORATION COMMISSION

MAY 21 1959 5-21-1959

(If additional description is necessary, use BACK of this sheet)

Name of Plugging Contractor QUAKER DRILLING CO., INC.  
Address 800 Bitting Building, Wichita, Kansas

STATE OF Kansas, COUNTY OF Sedgwick, ss.  
Thomas M. McCaul (employee of owner) or (owner or operator) of the above-described well, being first duly sworn on oath, says: That I have knowledge of the facts, statements, and matters herein contained and the log of the above-described well as filed and that the same are true and correct. So help me God.

(Signature) Thomas M. McCaul  
800 Bitting Building, Wichita, Kansas  
(Address)

SUBSCRIBED AND SWORN TO before me this 19th day of May, 1959

Washie Bell

Notary Public.

My commission expires September 14, 1961

PLUGGING  
FILE SEC. 1 T. 21 R. 14W  
BOOK PAGE 12 LINE 17

WELL LOG

ALPINE OIL & ROYALTY CO., INC.

Commenced: May 7, 1959

Contractor: Quaker Drilling Co., Inc.

Completed: May 17, 1959

Wayne L. Morrison No. 1 "B"  
NW SW SE Section 1-21S-14W  
Stafford County, Kansas

Elevation: 1920 KB

Production: D & A

CASING RECORD

Set 8 5/8 inch casing at 280 feet with 275 sacks cement

(Figures Indicate the Bottom of the Formations)

<u>FORMATION</u>	<u>DEPTH</u>	<u>FORMATION TOPS</u>	
Surface Soil	20	Anhydrite	809
Sand	420	Heebner Shale	3216 -1296
Red Bed	809	Brown Lime	3331 -1411
Shale and Shells	1650	Lansing-Kansas City	3342 -1422
Lime and Shale	1768	Base of Kansas City	3565 -1645
Lime	1875	Conglomerate	3571 -1651
Lime and Shale	2223	Viola Chert	3580 -1660
Shale and Lime	3148	Simpson Shale	3612 -1692
Lime	3223	Arbuckle	3664 -1744
Shale and Lime	3332	Rotary Total Depth	3700 -1780
Lime	3415		
Lime and Shale	3542		
Cherty Lime and Shale	3615		
Shale and Lime	3665		
Lime	3700		

We hereby certify the foregoing to be a true and correct copy of the Driller's Log of the well drilled in the NW SW SE of Section 1, Township 21 South, Range 14 West, in Stafford County, Kansas.

QUAKER DRILLING CO., INC.

By: Thomas M. McCaul  
Thomas M. McCaul, President

SUBSCRIBED AND SWORN to before me, a Notary Public, this 19th day of May, 1959.

Yashti Bell  
Yashti Bell, Notary Public

MY COMMISSION EXPIRES:  
September 14, 1961

RECEIVED  
STATE CORPORATION COMMISSION  
MAY 21 1959

PLUGGING  
FILE SEC 1 T. 21 R. 14W  
BOOK PAGE 40 LINE 17