


WELL PLUGGING RECORD

Give All Information Completely
Make Required Affidavit
Mail or Deliver Report to:
Conservation Division
State Corporation Commission
800 Bittling Building
Wichita, Kansas

NORTH

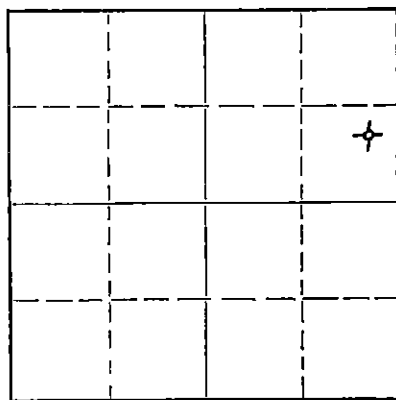

Locate well correctly on above Section Plat

Stafford County. Sec. 5 Twp. 21 Rge. 14 (E) W (W)
Location as "NE/CNW&SW" or footage from lines. C NE SE NE
Lease Owner The Derby Oil Company
Lease Name Dortschaffer Well No. 1
Office Address P.O. Box 1030, Wichita, Kansas
Character of Well (completed as Oil, Gas or Dry Hole) Dry Hole
Date well completed June 19, 1953
Application for plugging filed June 19, 1953
Application for plugging approved June 19, 1953
Plugging commenced June 19, 1953
Plugging completed June 19, 1953
Reason for abandonment of well or producing formation Dry Hole

If a producing well is abandoned, date of last production 19____
Was permission obtained from the Conservation Division or its agents before plugging was commenced? Yes

Name of Conservation Agent who supervised plugging of this well M. A. Rives
Producing formation _____ Depth to top _____ Bottom _____ Total Depth of Well 3610 Feet
Show depth and thickness of all water, oil and gas formations.

OIL, GAS OR WATER RECORDS

CASING RECORD

FORMATION	CONTENT	FROM	TO	SIZE	PUT IN	PULLED OUT
		0	829	8 5/8	829	None

Describe in detail the manner in which the well was plugged, indicating where the mud fluid was placed and the method or methods used in introducing it into the hole. If cement or other plugs were used, state the character of same and depth placed, from _____ feet to _____ feet for each plug set.

From 3610' to 271 1/2' - Heavy rotary mud
271 1/2' to 270' - Wooden plug
270' to 208' - 20 sacks cement
208' to 41 1/2' - Heavy rotary mud
41 1/2' to 40' - Wooden Plug
40' to 6' - 10 sacks cement
6' to surface - cellar

7-3-1953

RECEIVED
STATE CORPORATION COMMISSION

JUL 3 1953

CONSERVATION DIVISION
Wichita, Kansas

(If additional description is necessary, use BACK of this sheet)

Name of Plugging Contractor Glenn W. Peel
Address P.O. Box 359, Hoisington, Kansas

STATE OF Kansas, COUNTY OF Barton, ss.
Glenn W. Peel (employee of owner) or (owner/operator) of the above-described well, being first duly sworn on oath, says: That I have knowledge of the facts, statements, and matters herein contained and the log of the above-described well as filed and that the same are true and correct. So help me God. GLENN W. PEEL

(Signature) BY: *Herbert*
P.O. Box 359, Hoisington, Kansas
(Address)

SUBSCRIBED AND SWORN TO before me this 23rd day of June, 1953

Marian M. Herbert
Notary Public.

My commission expires June 4, 1955

