


WELL PLUGGING RECORD

Give All Information Completely  
Make Required Affidavit  
Mail or Deliver Report to:  
Conservation Division  
State Corporation Commission  
800 Bittling Building  
Wichita, Kansas

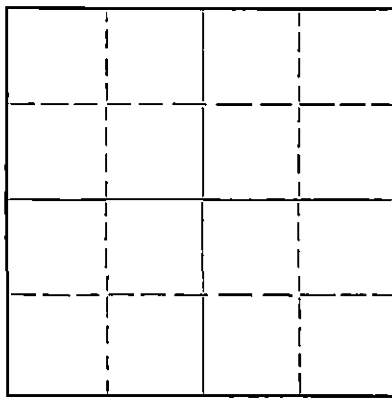

Locate well correctly on above  
Section Plot

Stafford County. Sec. 5 Twp. 21 Rge. 14 (X) (W)  
Location as "NE/CNW $\frac{1}{4}$ /SW $\frac{1}{4}$ " or footage from lines NW NW NW  
Lease Owner The Palmer Oil Corporation  
Lease Name Keeley Well No. 2  
Office Address Union National Bank Bldg., Wichita 2, Kansas  
Character of Well (completed as Oil, Gas or Dry Hole) Dry Hole  
Date well completed February 28, 1953  
Application for plugging filed February 28, 1953  
Application for plugging approved February 28, 1953  
Plugging commenced February 28, 1953  
Plugging completed February 28, 1953  
Reason for abandonment of well or producing formation Dry Hole

If a producing well is abandoned, date of last production 19...  
Was permission obtained from the Conservation Division or its agents before plugging was commenced? Yes

Name of Conservation Agent who supervised plugging of this well C. D. Stough  
Producing formation Depth to top Bottom Total Depth of Well 3743 Feet  
Show depth and thickness of all water, oil and gas formations.

OIL, GAS OR WATER RECORDS

CASING RECORD

Formation	Content	From	To	Size	Put In	Pulled Out
				8 5/8	878	None

Describe in detail the manner in which the well was plugged, indicating where the mud fluid was placed and the method or methods used in introducing it into the hole. If cement or other plugs were used, state the character of same and depth placed, from... feet to... feet for each plug set.

Filled hole with heavy mud to 300 feet  
Run plug and cemented with 20 sacks cement.  
Filled hole to 40 feet. Run plug and cemented with 10 sacks cement

FILED  
STATE CORPORATION COMMISSION  
WICHITA - KANSAS  
CONSERVATION DIVISION  
WICHITA, KANSAS  
3-7-1953

(If additional description is necessary, use BACK of this sheet)  
Name of Plugging Contractor The Palmer Oil Corporation  
Address 415 Union National Bank Building, Wichita 2, Kansas

STATE OF Kansas, COUNTY OF Sedgwick, ss.  
Edgar E. Smith (employee of owner) or (owner or operator) of the above-described well,  
being first duly sworn on oath, says: That I have knowledge of the facts, statements, and matters herein contained and the log of the above-described well as filed and that the same are true and correct. So help me God.

(Signature) *Edgar E. Smith*  
Wichita 2, Kansas (Address)

SUBSCRIBED AND SWORN to before me this 6th day of March, 1953.  
*Iris Meyer* Notary Public.

My commission expires July 23, 1955

PLUGGING  
FILE SEC 5 T 21 R 14W  
BOOK PAGE 81 LINE 37

WELL LOG - KEELEY #2

WELL OWNER: The Palmer Oil Corporation

Location: NW NW NW  
Section 5-21S-14W  
Stafford County, Kansas  
Elevation: 1923 R. B.

CONTRACTOR: The Palmer Oil Corporation

Commenced: 2/17/53

Completed: 2/28/53

RESULTS: Dry Hole

Casing Record

8 5/8" - 878' cemented 350 sacks

Figures indicate bottom of formation

Shale and sand	400
Sand	560
Red Bed	625
Shale and shells	866
Anhydrite	878
Shale	905
Shale & shells	1340
Sand	1500
Shale & shells	1730
Shale & lime	2065
Lime	2090
Lime & shale	3115
Lime	3260
Lime & shale	3340
Lime	3603
Conglomerate	3674
Arbuckle	3743 T. D.

Formation Tops (R. B.)

Heebner	3240
Brown Lime	3341
Lansing	3351
Conglomerate	3608
Simpson	3630
Arbuckle	3674

This is to certify that the above is a true and correct log, according to the daily drilling reports.

THE PALMER OIL CORPORATION

By Edgar E. Smith

STATE OF KANSAS )  
SEDGWICK COUNTY ) ss:

Subscribed and sworn to before me, a Notary Public in said County and State, this 6th day of March, 1953.

Aris Meyer  
Notary Public

My Commission Expires: 7/23/55.

MAR - 7 1953  
CONSERVATION DIVISION  
Wichita, Kansas

**PLUGGING**  
FILE NO. 5-T-21-R-1417  
BOOK PAGE 81-LINE 37