


WELL PLUGGING RECORD

Give All Information Completely  
Make Required Affidavit  
Mail or Deliver Report to:  
Conservation Division  
State Corporation Commission  
800 Bittling Bldg.  
Wichita, Kansas

Stafford County, Sec. 5 Twp. 21S Rge. (E) 11 (W)

NORTH

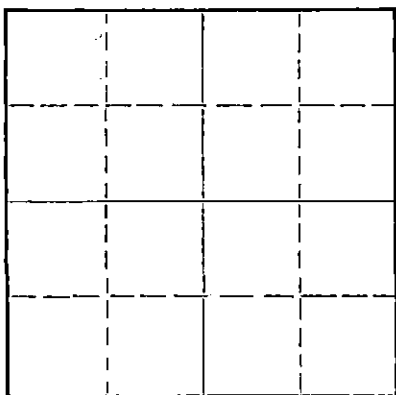

Locate well correctly on above  
Section Plat

Location as "NE/CNW/SW" or footage from lines NW NW SW  
Lease Owner Greenland Drilling Company  
Lease Name Keeley Well No. 1  
Office Address 506 Union National Bank Bldg., Wichita, Kansas  
Character of Well (completed as Oil, Gas or Dry Hole) Dry Hole  
Date well completed 6/28 1955  
Application for plugging filed 6/28 1955  
Application for plugging approved 6/28 1955  
Plugging commenced 6/28 1955  
Plugging completed 6/28 1955  
Reason for abandonment of well or producing formation Dry Hole

If a producing well is abandoned, date of last production \_\_\_\_\_ 19\_\_\_\_  
Was permission obtained from the Conservation Division or its agents before plugging was commenced? Yes

Name of Conservation Agent who supervised plugging of this well Warren H. Norner  
Producing formation \_\_\_\_\_ Depth to top \_\_\_\_\_ Bottom \_\_\_\_\_ Total Depth of Well 3715 Feet  
Show depth and thickness of all water, oil and gas formations.

OIL, GAS OR WATER RECORDS

CASING RECORD

FORMATION	CONTENT	FROM	TO	SIZE	PUT IN	PULLED OUT
				8-5/8	211	None

Describe in detail the manner in which the well was plugged, indicating where the mud fluid was placed and the method or methods used in introducing it into the hole. If cement or other plugs were used, state the character of same and depth placed, from \_\_\_\_\_ feet to \_\_\_\_\_ feet for each plug set.

Put good plug with hulls @ 210'  
and 20 sacks cement. Filled hole  
to 35' with mud. Put plug with  
hulls and 10 sacks cement. Plugging completed.

(If additional description is necessary, use BACK of this sheet)

Name of Plugging Contractor Greenland Drilling Company  
Address 506 Union National Bank Bldg., Wichita, Kansas


STATE OF KANSAS, COUNTY OF SEDGWICK, ss.  
Richard S. Davis (employee of owner) or (owner or operator) of the above-described well, being first duly sworn on oath, says: That I have knowledge of the facts, statements, and matters herein contained and the log of the above-described well as filed and that the same are true and correct. So help me God.

(Signature) Richard S. Davis  
Richard S. Davis, Vice-President  
506 Union National Bank Bldg.  
(Address)

SUBSCRIBED AND SWORN to before me this 6th day of July, 1955

My commission expires March 15, 1956.

Verdina B. Rutledge  
Verdina B. Rutledge, Notary Public.  
STATE CORPORATION COMMISSION

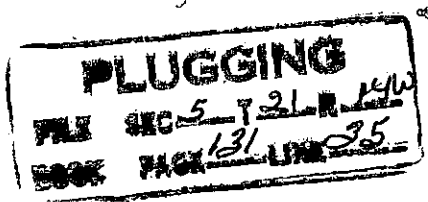

JUL 9 1955  
CONSERVATION DIVISION  
Wichita, Kansas  
7-8-1955

## WELL LOG

Company: GREENLAND DRILLING COMPANY

Sec. 5 T. 21S. R. 14W

Farm: KEELEY

No. 1

Loc.: NW NW SW

Stafford County, Kansas

Total Depth: 3715

Commenced: 6-18-55

Completed: 6-28-55

Contractor: Greenland Drilling Co.

Casing: 8-5/8" 211'

5-1/2" --

Production: D &amp; A

Elevation: 1927 R.B.

Figures Indicate Bottom of Formation

95	Slay and Sand
170	Sand & shale
211	Shale & shells
310	Shale & shells
405	Sand
868	Shale, shells & red bed
896	Anhydrite
1175	Shale & shells
1490	Shale & lime w/salt
1680	Shale & lime
1745	Lime w/shale breaks
2060	Lime & shale
2125	Lime
2145	Shale w/lime streaks
2600	Lime
2690	Shale
2715	Lime
2750	Shale
2960	Shale & lime
3030	Shale & lime w/salt
3170	Lime
3221	Lime & shale
3260	Lime
3274	Lime & shale
3348	Shale & sandy shale
3352	Brown lime
3355	Shale
3392	Lansing lime
3606	Lime
3642	Lime & chert
3684	Shale
3715	Lime
3715	T.D.

## TOPS:

Heebner	3244
Brown Lime	3346
Lansing	3355
Viola	3608
Simpson	3640
Arbuckle	3684

STATE OF KANSAS, COUNTY OF SEDGWICK, ss.

I, RICHARD S. DAVIS, Vice-President of the Greenland Drilling Company, upon oath state that the above and foregoing is a true and correct copy of the log of the #1, Keeley well.

*Richard S. Davis*  
Richard S. Davis, Vice-President

Subscribed and sworn to before me this 6th day of July, 1955.

My commission expires March 15, 1956.

*Verdina B. Rutledge*  
Verdina B. Rutledge, Notary Public

RECEIVED  
STATE OF KANSAS COMMISSION

JUL 8 - 1955

CONSERVATION DIVISION  
Wichita, Kansas

