


STATE OF KANSAS
STATE CORPORATION COMMISSION

Give All Information Completely
Make Required Affidavit
Mail or Deliver Report to:
Conservation Division
State Corporation Commission
211 No. Broadway
Wichita, Kansas

WELL PLUGGING RECORD

NORTH

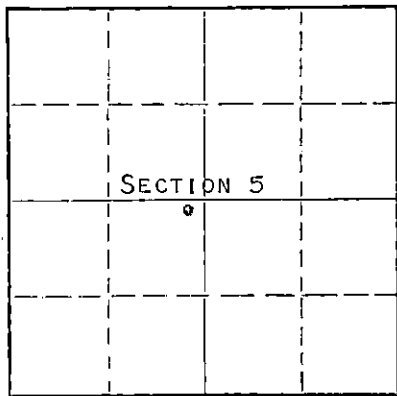

Locate well correctly on above
Section Plat

STAFFORD County, Sec. 5 Twp. 21S Rge. 14W (X) X (W)
Location as "NE/CNW/SW" or footage from lines NE NE SW
Lease Owner PETROLEUM, INC.
Lease Name KEELEY "B" Well No. 1
Office Address ROUTE 2, GREAT BEND, KANSAS
Character of Well (completed as Oil, Gas or Dry Hole) OIL
Date well completed APRIL 27, 19 59
Application for plugging filed JANUARY 22, 19 62
Application for plugging approved FEBRUARY 13, 19 62
Plugging commenced FEBRUARY 14, 19 62
Plugging completed FEBRUARY 28, 19 62
Reason for abandonment of well or producing formation DEPLETION OF PRODUCIBLE FORMATION

If a producing well is abandoned, date of last production JANUARY 25, 19 62
Was permission obtained from the Conservation Division or its agents before plugging was commenced? YES

Name of Conservation Agent who supervised plugging of this well W. L. LACKAMP, JR.
Producing formation KANSAS CITY Depth to top 3326' Bottom 3550' Total Depth of Well 3625' Feet
Show depth and thickness of all water, oil and gas formations.

OIL, GAS OR WATER RECORDS

CASING RECORD

FORMATION	CONTENT	FROM	TO	SIZE	PUT IN	PULLED OUT
KANSAS CITY	WATER AND LITTLE OIL	3525'	3530'	8-5/8" 5-1/2"	512' 3624'	NONE 1952'

Describe in detail the manner in which the well was plugged, indicating where the mud fluid was placed and the method or methods used in introducing it into the hole. If cement or other plugs were used, state the character of same and depth placed, from feet to feet for each plug set.

PLUGGED BACK T.D. 3550'

FILLED HOLE WITH CRUSHED ROCK FROM 3550' TO 3500'. PLACED 4 SACKS CEMENT ONTO CRUSHED ROCK TO 3470'. FILLED HOLE WITH HEAVY MUD TO 250' AND BUILT SOLID ROCK BRIDGE. GLOBE CEMENTING COMPANY FILLED HOLE TO BASE OF WELL CELLAR WITH 75 SACKS CEMENT.

RECEIVED
STATE CORPORATION COMMISSION

MAR 16 1962

CONSERVATION DIVISION
Wichita, Kansas

(If additional description is necessary, use BACK of this sheet)

Name of Plugging Contractor MORGAN WELL PLUGGING SERVICE
Address 102 WEST 18TH STREET, HUTCHINSON, KANSAS

STATE OF KANSAS, COUNTY OF BARTON, ss.
DON SEARLE (employee of owner) or (owner/operator) of the above-described

well, being first duly sworn on oath, says: That I have knowledge of the facts, statements, and matters herein contained and the log of the above-described well as filed and that the same are true and correct. So help me God. DON SEARLE, DIST. PROD. SUPT.

(Signature) Don Searle

ROUTE 2, GREAT BEND, KANSAS
(Address)

SUBSCRIBED AND SWORN TO before me this 14TH day of MARCH, 19 62

My commission expires APRIL 14, 1963.

Arthur J. Miles
Notary Public.



WELL LOG

15.185.00301.0000

COMPANY **PETROLEUM, INCORPORATED**

SEC. 5 T. 21S R. 14W

FARM **KEELEY "B"** NO. 1

LOC. NE, NE, SW


TOTAL DEPTH **3625'**

COUNTY **STAFFORD CO., KANSAS**

COMM. **April 8, 1959**

COMP. **April 18, 1959**

CONTRACTOR **GARVEY DRILLING COMPANY**

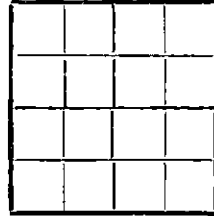

CASING **8 5/8" @ 512' W/325 sax.**
5 1/2" @ 3624' W/100 sax.

ELEVATION **1923' DF**

PRODUCTION **KANSAS CITY**

FIGURES INDICATE BOTTOM OF FORMATIONS

160	Sand & gravel
175	Sand
290	Clay & shale
395	Sand
855	Red bed
880	Anhydrite
1460	Shale
1840	Shale & lime
2195	Lime
2385	Lime & shale
2775	Shale & lime
3075	Lime & shale
3360	Lime
3400	Lime & shale
3543	Lime
3625	Lime & chert
3625	T. D.

RECEIVED
STATE CORPORATION COMMISSION
MAR 15 1962
CONSERVATION DIVISION
Wichita, Kansas

State of KANSAS }
County of BARTON } SS:

I, VERNE A. MORRIS of GARVEY DRILLING COMPANY

upon oath state that the above and foregoing is a true and correct copy of the log of the #1 KEELEY "B" well

Verne A. Morris

Subscribed and sworn to before me this 19th day of May 19 59

My Commission Expires: April 14, 1963

Arthur J. Miles
NOTARY PUBLIC