

STATE OF KANSAS
STATE CORPORATION COMMISSION

Form CP-1

Give All Information Completely
Make Required Affidavit
Mail or Deliver Report to
Conservation Division
State Corporation Commission

WELL PLUGGING RECORD

P. O. Box 17027
Wichita, Kansas 67217

Locate well correctly on above
Section Plat

Stafford County, Sec. 5 Twp. 21 Rge. 14 (E) (W) x
 Location as "NE/CNW/SW" or footage from lines NE NW NE
 Lease Owner National Cooperative Refining Assn.
 Lease Name Dorfshaffer Well No. #3
 Office Address Box 6, Great Bend, Kansas
 Character of Well (completed as Oil, Gas or Dry Hole)
 Date well completed 19
 Application for plugging filed 19
 Application for plugging approved 19
 Plugging commenced 4-10-74 19
 Plugging completed 4-12-74 19
 Reason for abandonment of well or producing formation
 If a producing well is abandoned, date of last production 19
 Was permission obtained from the Conservation Division or its agents before plugging was commenced?

Name of Conservation Agent who supervised plugging of this well G. R. Biberstein
 Producing formation Depth to top Bottom Total Depth of Well 3640' Feet
 Show depth and thickness of all water, oil and gas formations.

OIL, GAS OR WATER RECORDS

CASING RECORD

FORMATION	CONTENT	FROM	TO	SIZE	PUT IN	PULLED OUT
				5 1/2"	3600'	2759.73'
				8 5/8"	845'	

Describe in detail the manner in which the well was plugged, indicating where the mud fluid was placed and the method or methods used in introducing it into the hole. If cement or other plugs were used, state the character of same and depth placed, from feet to feet for each plug set.

Made bottom hole plug back with sand to 3350'. Mixed and ran 5 sacks cement thru dump bailer.
 Mudded hole to 375' - set 25' rock bridge. Filled hole with 5 yards ready-mix from 350' to base of cellar.

RECEIVED
 STATE CORPORATION COMMISSION
 APR 15 1974
 CONSERVATION DIVISION
 Wichita, Kansas

Name of Plugging Contractor Southwest Casing Pulling Co. (If additional description is necessary, use BACK of this sheet)
 Address Box 364 Great Bend, Kansas

STATE OF Kansas COUNTY OF Barton ss.
 Southwest Casing Pulling Co. (employen of owner) or (owner or operator) of the above-described well, being first duly sworn on oath, says: That I have knowledge of the facts, statements, and matters herein contained and the log of the above-described well as filed and that the same are true and correct. So help me God.

(Signature) W. C. Spencer
 Box 364 Great Bend, Kansas
 (Address)
 Signed and sworn to before me this 13 day of April 1974


Notary Public Seal: WILHELM SYDNEY MILLER, Notary Public, State of Kansas, Commission Expires 12/31/75, 123015, DAB

Sidney D. Miller
 Notary Public.

WELL LOG BUREAU—KANSAS GEOLOGICAL SOCIETY
608 East Murdock, Wichita, Kansas

Company- NATIONAL COOPERATIVE REFINERY ASS'N. SEC. 5 7. 21 R. 14W
Farm- Dorfshaffer No. 3 NE NW NE

Total Depth. 3640
Comm. 3-31-53 Comp. 4-13-53
Shot or Treated.
Contractor. Braden Drilling Co.
Issued. 5-30-53

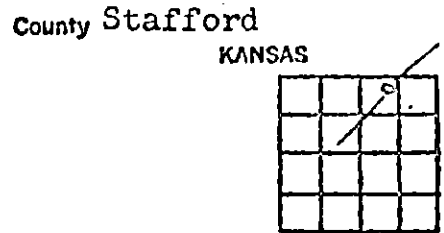

8 5/8 CASING: 845' w/ 450 sx cement

Elevation. 1923 DF
Production. Dry

Figures Indicate Bottom of Formations.

sand & clay	160
shale	220
sand & shale	510
red bed & shale	835
anhydrite	870
shale & shells	1575
lime	1615
lime & shale	1680
lime	1770
lime & shale	2015
lime	2155
lime & shale	2705
lime	2800
lime & shale	3065
lime	3594
Arbuckle lime	3640
Total Depth	
SCOUT TOPS:	
Anhydrite	835
Heebner	3195
Brown lime	3297
Lansing	3307
Arbuckle	3591

RECEIVED
STATE CORPORATION COMMISSION
FEB 21 1974
CONSERVATION DIVISION
Wichita, Kansas